


RENEW C.C. 33/34 T 275 R 6W

FOUND - 20" ASH NOV 30" N 76 1/2° E  
1980 SHOWS GOOD SCRIBING ON  
OLD FACE R 2" N W BT NOT  
FOUND.

FENCE THIS

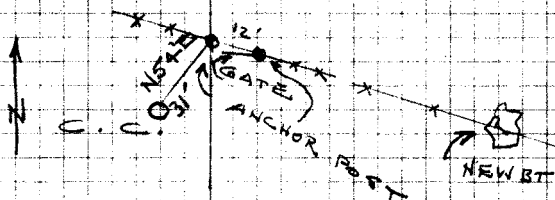

SET BRASS CAP AT CORNER  
MAD C.C. 33/34 T 275  
R 6W

COUNTY SURVEYORS OFFICE 1961

NEW BT.

54" FORKED W. OAK S 63° E 307 1/2'  
SCRIBED (ABOVE WIRE FENCE)  
C.C. 333 - 334 CS BT.

VAR 20 1/2'

JAN. 16 - 61  
U. D.  
D. O. G.

✓✓ C.S. File No. 49/79-14

DIETZEN N. D. 385-B

