

RENEW SEC. COR 36/3/T275

1 T285

FOUND - BOTH PTS. RECORDED BY
EACH SHOWS MARKING
MAY HAVE BEEN DROPPED
OF POSITION WERE AT 20
NON BOLT SET FOR AT 20
NOTE SEE FILE IN 159
AND M 1-73.

COR IS IN OLD LOGGING ROAD
COR RESET BY TRAVERSE FROM
NORTH LINE OF RANGE

SET BRASS CAP AT COR MWD
COUNTY SURVEYORS 1961

530/21 T275

51 T285

FOR R2W


NEW BT. 32' B. ON 1 B. LRS
R26W T285.3 SURVEYED
36 T275 R & W COR BT

S36

R28W

MAY 26-61

U. S. G.
D. P.

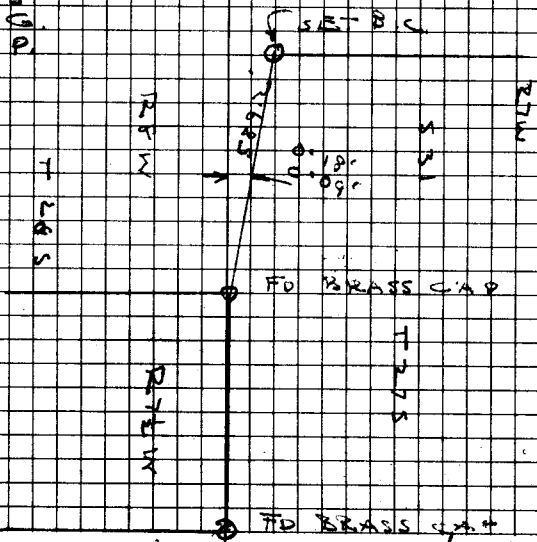

DIETZGEN NO. 385-6

* S/1961

✓ ✓ ✓

C.S. 49/99-34