

40
CRO

57° 40' W

48.4

30° 10' 20"

SEARCH FOR 1/4 COR. 25/30 T275
R/W R/W


FOUND - TWO SCRIBED TABLES. NOW
40" CEDAR SHOWS SCRIBING ON CHIP
RESTING IN OLD WINDOW ALSO SCRIBING
WAS IN WOOD BEHIND CHIP.

THIS TABLE HAS BEEN USED FOR
ORIG SURVAY BT. BY OTHERS. FACTS
OK BUT I DO NOT BELIEVE IT
PLACES COR. AT COR. POSITION.
AS WE FIND OLD TABLES
SCRIBING MAY NOT BE ORIG.

WE FIND NOW 30" TABLES WE
OPEN & FIND SCRIBING. PROBABLY
SCRIBED BY TABLE 1881 TABLES
TOWARD CEDAR BT. THIS SCRIBING
AND FACE WAS PARTLY DESTROYED
BY AXE WORK APPARENTLY SOON
AFTER IT WAS SCRIBED. WE FIND
NO SCRIBING FACING TO N.E. ALSO
IT PUTS THE COR. NEAR OTHER
LARGER & OLDER TABLES.

I DOUBT IF EITHER BT IS ON
ORIG. BT. OR THE RECORD WITH
BEARINGS ARE N.G.

BTS. THIS

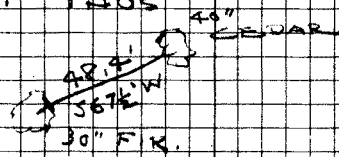

JUN 9 - 1960
M. J. [unclear]

DIETZGEN NO. 385.6