


RENEW $\frac{1}{4}$ COR. 30 T27S R7W
BT

FOUND - BOTH BTS AS RECORDED
BY F.P.D. 1930 SEE C.S. FILE #59
BTS ALIVE & IN GOOD CONDITION
I OPEN EACH BT & FIND GOOD
SCRIBING & BOTH CHECK FOR DIST. BUT
I FIND THE S 47° 15' W BT SHOULD
BE S 52° W & S 85° E BT SHOULD
BE S 84° E
I SET BRASS CAP AT COR. MKD

$\frac{1}{4}$ S 30 T27S R7W COUNTY SURVEYORS
S 31 OFFICE 1958.

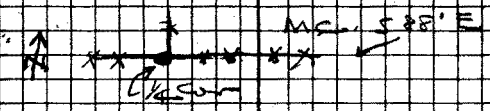

NEW BTS.
14" CEDAR BEARS S 46° W 413'
SCRIBED. $\frac{1}{4}$ S 31 C 2 BT.

RECORDED S 84° E 135' New
20" W.D. $\frac{1}{4}$ S 31 C 2 BT.

APRIL 23-58
J.B.
M.C.
J.B.

FILED
RECEIVED

APR 23 1958

COUNTY SURVEYOR
JONES COUNTY, ORE

C. S. File No. 49/791

DIETZGEN NO. 388-6