

KENEY 23/24  
26/25 T 275 R 1 W

FOUND - ORIG. 12" NOW 26" OAK  
575' E R 1, 8' WE OPEN & FIND GOOD  
SCRIBING "S". WE ALSO FIND STUMP  
LITTLE THAT CHECKS FOR ORIG. NE  
BT. WE FIND 3/8" I.B. WITH Y STRAP  
ON TOP AT COR.

SET BRASS CAP AT CORNER, MAD  
COUNTY SURVEYORS OFFICE 1960.

523/524  
526/525 T 275 R 1 W

NEW BTS.  
9" B. OAK BEAMS N 40° E 22.4'  
SCRIBED S 24 T 275 R 1 W CSBT

15" B. OAK BEAMS S 60° E 34.2'  
SCRIBED S 25 T 275 R 1 W CSBT


6" B. OAK BEAMS S 58° W 9.0'  
SCRIBED S 26 T 275 R 1 W CSBT

NO TREES NEAR TO NW

DIETRZEN NO. 385.6

Nov. 1960  
J. B.  
M. G.  
D. P.

COR. T 1 U 5

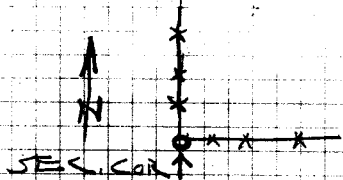

\*

C. S. File No. 49/79 23