

RENEW  $\frac{517}{819}$  T275 R7W

FOUND - ORIG 15' NOW 20' DEAD CEDAR  
PARTLY BURIED S 55° W 92' SHOWS  
SCARPS. ORIG 24" NOW 32" PARTLY  
PARTIAL FIR STUMP S 30° E 200' WE  
OPEN & FIND GOOD SCRIBING. BT  
WE ALSO FIND STUMP OF ORIG NE  
BT ORIG. NOW BT GONE. WE  
FIND 16" X 5" X 16" COR. STONE  
WITH H ON TOP. AT A WAY  
FENCE INTERSECTION.

COR. STONE IS GOOD WE DO NOT  
SET BRASS CAP.

NEW BT.

6" LAUREL BEAMS N 86° W 376'  
SCRIBED 55 CS BT.


NO OTHER TREES NEAR.

RENEW  $\frac{1}{4}$  COR. 4 T275 R7W

FOUND - BOTH BTS AND COR STONE  
AS RECORDED BY B. B. T. WE OPEN  
SW BT & FIND GOOD SCRIBING.  
SW BT NOW DEAD NW BT STUMP.

SET BRASS CAP ALONGSIDE COR  
STONE WND. COUNTY SURVEYORS  
OFFICE 4960  $\frac{1}{4}$   $\frac{52}{55}$  - 275 R7W

COR. TIER

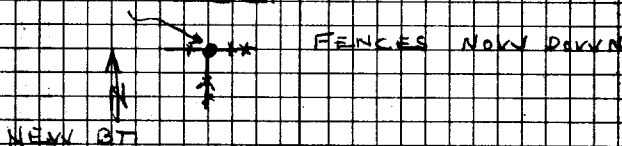

12" R FIR BEAMS N 53° E 440'  
SCRIBED  $\frac{1}{4}$  S 40 CS BT.

NO TREES NEAR TO SOUTH.

DEC 7 - 60 C.S. File No. 49/792  
J.B. M.B. C.P.