


RENEW  $\frac{1}{4}$  COR. 4/3 T275 R7W

FOUND - BOTH ORIG. BTS. ORIG.  
15" NOW 20" OAK SNAG S 58° E 71.9  
WE OPEN & FIND GOOD SCRIBING "B"  
12" NOW 18" OAK SNAG  
BEARD N 20° W 37.6) WE FIND TO  
BE N 20° W 37.6'. THIS BT.  
WAS ALSO OPENED & GOOD  
SCRIBING "A"  $\frac{1}{4}$  S.

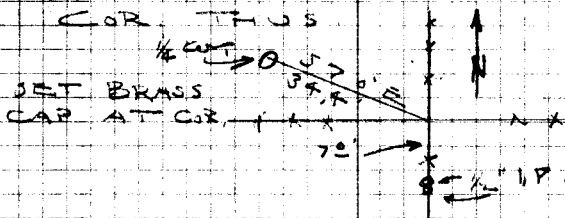

NEW BTS.

5" W. OAK BEARS S 4° E 47.5'  
SCRIBED  $\frac{1}{4}$  S3 CS BT

10" W. OAK BEARS S 84½° E 903'  
SCRIBED  $\frac{1}{4}$  S3 CS BT

RENEW  $\frac{1}{4}$  COR. T275 R7W

FOUND ORIG. 12" NOW 14" OAK  
N 71° W 68.4 I OPENED FIND GOOD  
SCRIBING "S" ORIG. TO NOW 49"  
OAK SNAG W 55° S 155.5 SHOWS GOOD  
BEAR I DO NOT OPEN  
SET BRASS AT COR. N100  $\frac{1}{4}$  S 3  
T275 R7W COUNTY 511  
SURVEYORS OFFICE 1960

7" PINE BEARS N 34° E 177.8  
SCRIBED  $\frac{1}{4}$  S 2 CS BT

7" PINE BEARS S 55° W 123.8  
SCRIBED  $\frac{1}{4}$  S 11 CS BT

\* 12/1960

✓ U.S. File No. 49/99-24