

T 27 S R 7 W

WIT COR. N.E. CORNER


D.L.C. # 43 - 15' South

J B

M 6

C D

JEC 23-10

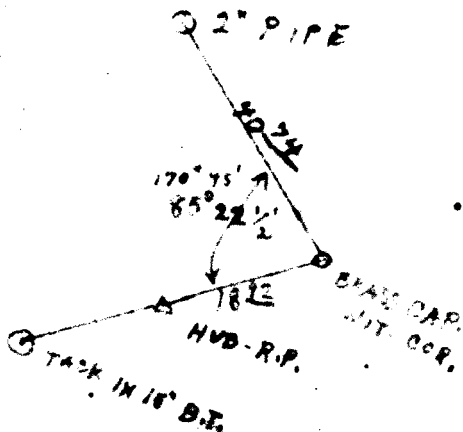

85 1/2  
 44 1/2  
 130 1/2

15" W. OAK S 46 1/2° W 44 1/2 FT.

20" W. OAK S 66° W 48 1/2 FT.

SET BRASS CAP  
WIT COR.

15 00

14 18

BRASS CAP  
N.E. COR.  
D.L.C.# 43

134 09  
27 05 1/2 R

32 58

2" PIPE

43 00  
21 00 R

139 50

2 57 1/2  
51 1 1/2

49/29-79