

RENEW NE COR. DLC #3 T275 R7W  
EB WIT COR. (BRASS CA) #

BOTH BTS. AS RECORDED

NOTE - THESE BTS. ARE TO BE  
REMOVED

NEW BTS.

20' W. OAK BEARS S 23° W 68.5'  
SCRIBED W.C. CL NE #3 CS BT

8' W. OAK BEARS S 15° E 57.0'  
SCRIBED W.C. CL NE #3 CS BT

VAR TO No AUG 8 - 1962  
H. B.  
B. S.

SEE SKETCH  
ATTACHED

FILED  
RECEIVED

AUG 8 1962

COUNTY SURVEYOR  
DOUGLAS COUNTY, NE

+\* O✓

C. S. File No. 19/79 10

DIETZEN NO. 388-S

▲ STA - 48+50  
E OF ROAD

● 2" PIPE

0° 30' 1/2"  
0° 15'

▲ STA 51+00

FILED  
RECEIVED

DEC 27 1960

COUNTY SURVEYOR  
DOUGLAS COUNTY, ORE

DIETZEN NO. 388-B

C-49/79-84 (2)

T 27 S R 7 W


WIT COR. N.E. CORNER

J. B

D.L.C. # 43 - 15' South

M. G  
O. P.

DEC 23-19

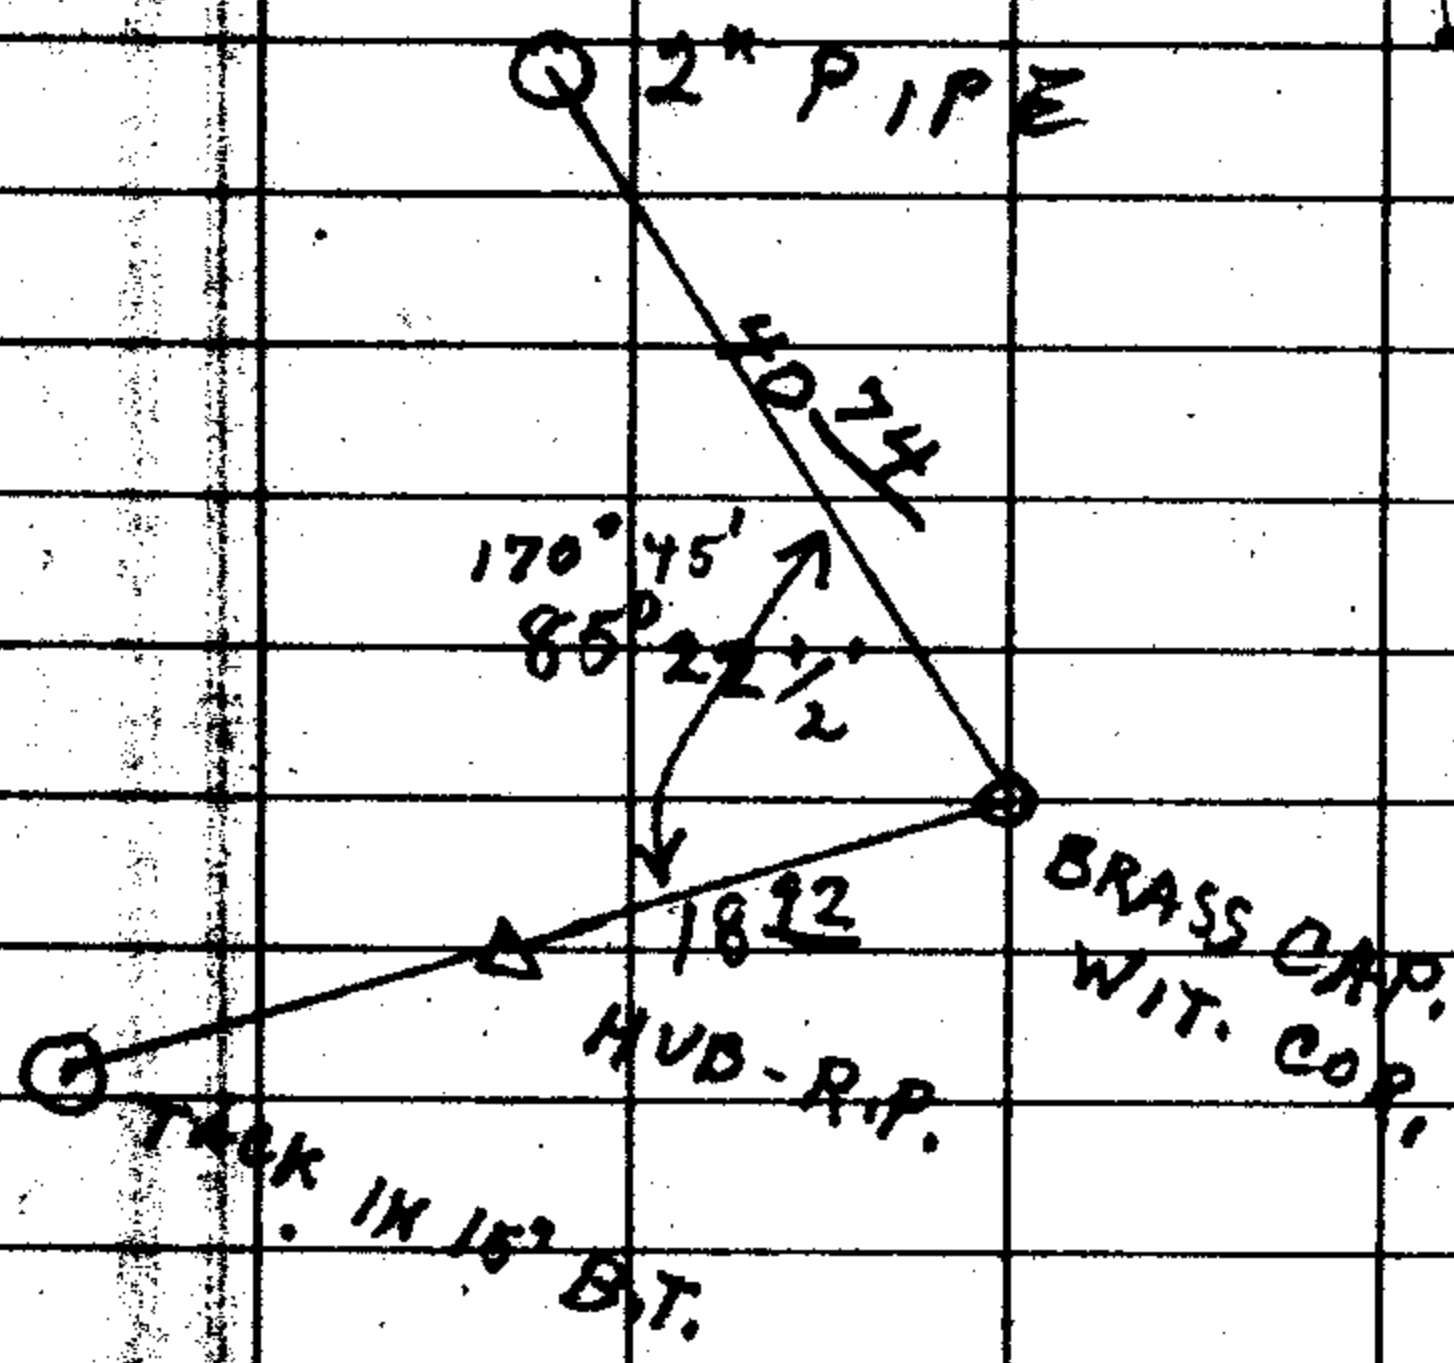

85  
4  
13 1/2  
4

15" W. OAK S 46 1/2° W 44 1/2 FT.

20" W. OAK S 66° W 48 1/2 FT.

SET BRASS CAP  
WIT. COR.

15 00

14 15

BRASS CAP  
N.E. COR.  
D.L.C. # 43

134° 07'  
67° 03 1/2' R

32 58

2" PIPE

43° 50'  
21° 55' R

139 50

ST  
51 + 50

✓

C. S. File No. 49/79 1/2