


RENEW SECTOR ULC FB T275R64

FOUND - BT AS RECORDED BY EPP. ^{see note}
1934 ALSO FIND 1" IRON SHAFT AT
COR. 12" UNDER SHAFT OF RD.
WE SET 3" I.P. OVER SHAFT
AND 1" UNDER SURFACE
WE FIND OLD PIPE THUS.

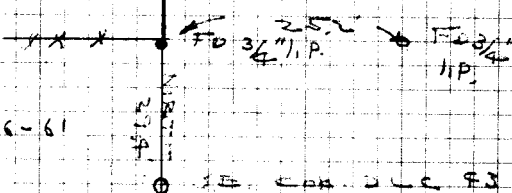

JUNE 16-61
J.B.
M.G.

SECTOR ULC FB

DIETZGEN NO. 385-6

VVO C.S. File No. 49/79-90

M&M

PRINTERS & LITHOGRAPHERS

OR 3-8591 - 242 S.E. Jackson - Roseburg, Oregon

Renew

S.E. Cor D.L.C. #3 T27-6W

This corner all but gone so
stakes B.L. see M12-45

B. L. TRACK LITON MAR. 22-61

S. ON E. BDRY

32.04 INTERSECT LINE BET. 3 & 10

0.20 CHS E. OF 1/4 POST

45.00 S/E. COR. D.L.C. # 43

SET STONE 30" X 8" X 4" IN PRAIRIE
MOUND & TRENCH

EPP-193K

SET 1" SHAFT

30" W. DAK N 71° E 466 FT.

G. & File No. 4919-98
(2)