

RENEW 13/18 T 295

ROW ROW

FOUND - ORIG (WHIRL) 20' Now 34"
 DOWN R/R 566 FT. 1958. MOST OF OLD
 FENCE BURNED BUT I DO FIND GOOD
 SCORING "R". I FIND NO TRACE OF
 ORIG. SW OR NE BPTS WITHIN RANGE OF
 OAK STUMP THAT APPEARS BEARING @
 DISTANCE FOR NXY BPT
 SET BRASS CAP AT COR. MAD COUNTY
 SURVEYORS OFFICE 1959.

5/31/59
 SEA 614

T 295

ROW ROW


NEW BPTS -

- 6" W. OAK BEARDS N 81° E 62.8'
- SCRIBED 58 TRAPS 1/2 IN. PART
- 6" W. OAK BEARDS N 42° 00' E 45.6'
- SCRIBED 5 13 TRAPS R/W CORNER
- 4" W. OAK BEARDS S 89° W 20.2'
- SCRIBED 5 24 TRAPS R/W CORNER
- 6" R. FIR BEARDS S 111° E 60.5'
- SCRIBED 5 9 TRAPS R/W CORNER

NOTE -

THIS CORNER RECORDED BY EVANS 1963
 HOWEVER AT THE TIME I FOUND NO EVIDENCE
 ON SNAG USED BY EVANS TO INDICATE IT TO
 BE A BPT. TODAY I TALKED TO MR. MC
 HUGGILL WHO WAS WITH EVANS JUST
 PRIOR TO THE 1958 RENEWAL. HE STATES
 THAT THERE WAS NO EVIDENCE THE
 SNAG USED BY EVANS WAS A BPT AT THAT
 TIME. ALSO IT APPEARS EVANS OBTAINED
 THE DISTANCE RECORDED BY WHEELER @
 616 FOR A BPT RECORDED BY WHEELER.
 EVANS COR. BEARS N 81° E 62.8'. I DESTROY
 ALL EVIDENCE OF HIS CORNER.

FENCE COR. TRUS V/R 2.0 E'

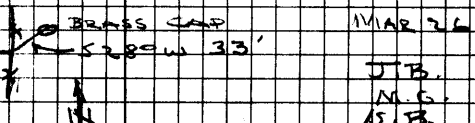

MAR 27 1959

NTY SURVEYOR
 GLAS COUNTY, ORE.

C. S. File No. 49/83.-

DIETZGEN NO. 385-6

ED
 CEIVED