


RENEW $\frac{1}{4}$ COR. 14 T 24S R6W
23

FOUND - ORIG. 28" NON 46" W.O.
N 25° W 155.8'. I OPEN & FIND
GOOD SCRIBING "BT".

SET BRASS CAP AT CORNER
MARKED COUNTY SURVEYORS OFFICE
1958. $\frac{1}{4}$ S 14 T 24S R6W
23

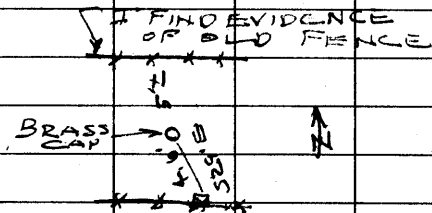

I FIND SCRIBED STAKE UNDER
NOT OLD FENCE. STAKE SET BY
THEM.

NEW BT3

12" W.O. N 25° W 109'

SCRIBED $\frac{1}{4}$ S 14 CS BT

12" B.O. S 23' W 158'

SCRIBED $\frac{1}{4}$ S 23 CS BT.

CS 49/83 - 20 ✓ ✓