

REN.

T 24 S R 6 W

COR.  
SECS.

28	27
33	34

AT COR. FD. ROCK 4" X 10" X 14"  
ABOVE GROUND. - ROCK MKD. WITH  
"X" ON TOP, 3 GROOVES ON E. FACE,  
1 GROOVE ON S. FACE, & "33" ON S.W.  
FACE.

FD. DEAD LAUREL SNAG (NOW 48" DIA.)  
S 50° E 70' FT. - N.E. SIDE COMPLETELY  
BURNED AWAY - NO SCRIBING OR OLD  
AXE MKS. FD.

FD. BLACK OAK - ALMOST COMPLETELY  
DEAD - (NOW 40" DIA.) S 67½° W 37' FT.  
TREE HOLLOW & N.E. SIDE COMPLETELY  
BURNED AWAY.

NO TRACE FD. OF N.E. OR N.W.

O.B.T.'S.

ALONGSIDE ROCK AT COR. SET IRON  
PIPE WITH BRASS CAP MKD. "COUNTY  
SURVEYOR'S OFFICE 1963 T 24 S R 6 W

S 28 | S 27  
S 33 | S 34

BLAZE & SCRIBE NEW TREES:

6" MADRONE S 12° E 59' FT.

MKD. "T 24 S R 6 W S 34 CS BT"

9" MADRONE S 4½° W 72' FT.

MKD. "T 24 S R 6 W S 33 CS BT"

12" DOUG. FIR N 60° W 133' FT.

MKD. "T 24 S R 6 W S 28 CS BT"

(BOTTOM OF BLAZE 3 FT. ABOVE GROUND)

NO TREE AVAILABLE TO N.E.

COR. IS IN E. & W FENCE LINE ON STEER  
WEST SLOPE, JUST E. OF ABANDONED  
MILL SITE.

SEPT. 5, 1963


Milo E. Giffen

M.G. - M.S.

Section 27 Twp 24S Rge 7 W

Date: 8/22/63

How was corner identified? Scribed stone - Bearing tree tag

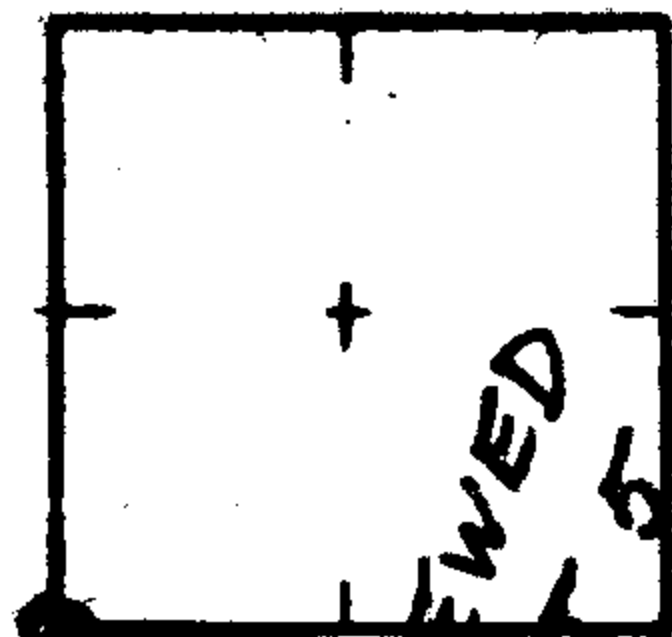

Condition of corner: \_\_\_\_\_

Best route to reach corner: Drive up road BLH Rd #24-7-33  
west of Sutherlin on Hwy #225

FILED

RECEIVED

Quadrant	NE	NW	SE	SW
Species & Size				
Dist. & Bearing				
COUNTY SURVEYOR				
of <del>Douglas</del> COUNTY, ORE.				
Appearance of B.T.				
Tags, Nails, etc.				

Other Remarks:

David W. Taylor

Signed

RENEWED  
SEPT 5, 1963  
Gibb E. Goffey

6?