

REN.

T 24 S R 8 W

COR. 15/14
SECS. 22/23

AT COR. FD. 2" SQUARED WOODEN
STAKE.

FD. DEAD FIR SNAG (NOW 38" DIAM.)

N 15° W 23 1/2 FT. - (TO FACE) - CUT OPEN

& FD. GOOD SCRIBING "BT"

FD. FIR STUB (NOW 26" DIAM.)

N 4° E 16 1/2 FT. - OPENED PREVIOUSLY -
FACE ROTTED AWAY.

FD. FIR - (OLD UPROOT-DOWN) S 42° W

17 1/2 FT. - BURL WOOD VISIBLE - BARK
GONE.

FD. STUMP HOLE - (FIR ROOTS & PORTION
OF STUMP REMAINING) - S 40° E 21 1/2 FT.

AT COR. SET IRON PIPE WITH

BRASS CAP MKD. "COUNTY SURVEYOR'S
OFFICE 1963 T 24 S R 8 W S 15 S 14"
S 22 S 23

BLAZE & SCRIBE NEW TREES:

6" DOUG. FIR N 69° E 9 1/2 FT.

MKD. "T 24 S R 8 W S 14 CS BT"

14" WHITE FIR S 18° E 28 1/2 FT.

MKD. "T 24 S R 8 W S 23 CS BT"

11" WHITE FIR S 59° W 24 1/2 FT.

MKD. "T 24 S R 8 W S 22 CS BT"

8" DOUG. FIR N 45° W 30 1/2 FT.

MKD. "T 24 S R 8 W S 15 CS BT"

COR. LIES ON STEEP NE SLOPE

APPROX. 100 FT. E. OF TOP OF RIDGE.

MAY 10, 1963

W. E. Coffey

M. G.
Y. T.


X X

Section 15/14
22/23

TWP 24 S Rge 8 W

#1 Date: 4/19/63

RENEWED MAY 20, 1963
Hild & Co. Loggers

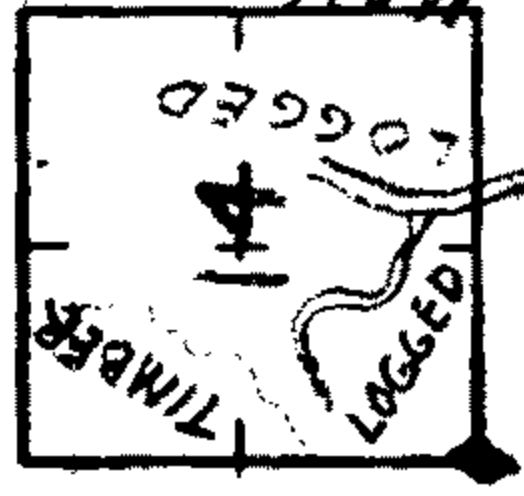

RADER CR.
ROAD

How was corner identified? 2 original B.T.'s

Condition of corner: Very bad shape - should be removed before it gets destroyed.

Best route to reach corner: Via SHOPT RANCH - WOLF CR
thence Rader Cr.

Quadrant	NE	NW	SE	SW
Species & Size	FIR	FIR		FIR
Dist. & Bearing	N4°E 25kfs	N15°W 35kfs		
Condition of Scribe	POOR	NEEDS CHOPPED OUT		
Original of Resurvey	ORIGINAL	ORIGINAL		ORIGINAL
Appearance of B.T.	STUB	SNAG	GONE	DOWN
Tags, Marks, etc.		YELLOW TAG		

Other Remarks:

Wait until a few days of sunshine and you can drive closer!

Bob Henderson

Signed
CS 49124-10 012