

RENEW N. $\frac{1}{4}$ 5 ONLY T245 R8W

Fl. 8" squared Post at cor pt. of

as follows -

ORIG. 15" NOW 40" FIR N. $16\frac{1}{2}^{\circ}$ W. 40[±] FT
OPEN & SHOWS " $\frac{1}{4}$ 5" SCRIBE - NOW
SM 29 25[±] FT HIGH.

ORIG 12" NOW 20" FIR S. 85° W. 52[±] FT,
Badly Rotted stump shows " $\frac{1}{4}$ 5" scribe.
we set 1" I.P. & BRASS CAP MKD.


"COUNTY SURVEYOR'S OFFICE 1965
T245 $\frac{1}{4}$ 5 1 R8W" & MK NEW BTs -

11" D. FIR S. 1° E 15[±] FT
MKD. " $\frac{1}{4}$ 5 1 CS BT"

8" D. FIR S. 67° W. 18[±] FT,
MKD. " $\frac{1}{4}$ 5 1 CS BT"

August 6, 1965

U.R.T.
M.S.
T.C.

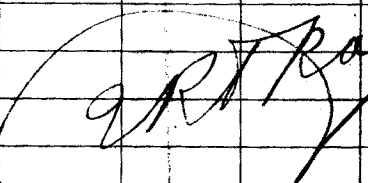

FILED
RECEIVED

AUG 9 1965

COUNTY SURVEYOR
DOUGLAS COUNTY, ORE.


231-292
+ X 230-23-8

1/2

C. S. File No. 49/84-11

Section 1 Twp 24S Rge 8 W

Date: 11-4-64

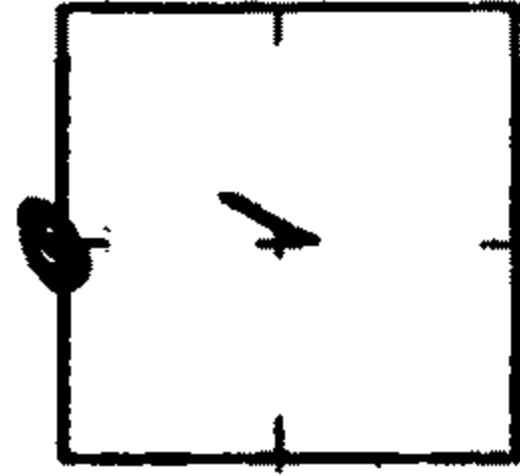

How was corner identified? Original bearing tree scribes

are present.

Condition of corner: Corner itself is missing; a wooden

stake references approx. location.

Best route to reach corner: Basin Creek (Bodkins) Road to

New BLM timber sale road in NE 1/4 Sec. 1.

2 B.T.'s.

Other Remarks:

A man from BLM
office can go with
party - clear marker
ready to re-establish.
672-4491 Ext. 46
Robert W. Beight

Quadrant	NE	NW	SE	SW
Species & Size				
Dist. & Bearing				
Condition of Scribe	<u>Removed</u>			
Original or Resurvey	<u>8/6/65</u>			
Appearance of B.T.				
Tags, Marks, etc.			<u>C5</u>	<u>49/84-11</u>

Signed

2/2