

Renew $\frac{1}{4}$ $\frac{32}{511}$ T245 R8W

Fd. ~~and~~ Live & Remains of other orig. BT's as follows -

Orig. 20" Now 40" Fir N. 4° W. 40[±] ft. open & shows "1" scribe & Reverse.

Orig. 60" Fir S. 15° W. 125 ft.

Now Shattered stump & has slid down the hill approx. 6° ft.

No scribe fd. We set 1" I.P. &

BRASS Cap MKd. "COUNTY SURVEYOR'S OFFICE 1965 T245 $\frac{1}{4}$ $\frac{32}{511}$ R8W"

& MK BT's -

New BT - 10" D. Fir S. 18° E. 10[±] ft.

Mkd. " $\frac{1}{4}$ S 11 CS BT"

Orig. 40" D. Fir N. 4° W. 40[±] ft.

Mkd. " $\frac{1}{4}$ S 2 CS BT"

This cor is on very steep west slope.

August 9, 1965

K.R.T.
M.D.
M.S.
etc.

FILED
RECEIVED

AUG 9 1965


Handwritten signature: G. R. Tracy

COUNTY SURVEYOR
DOUGLAS COUNTY, ORE.

+X#32

C. S. File No. 19/84-12
112

Section 2 Twp 24 S Rge 8 W 8 Date: 5/28/65

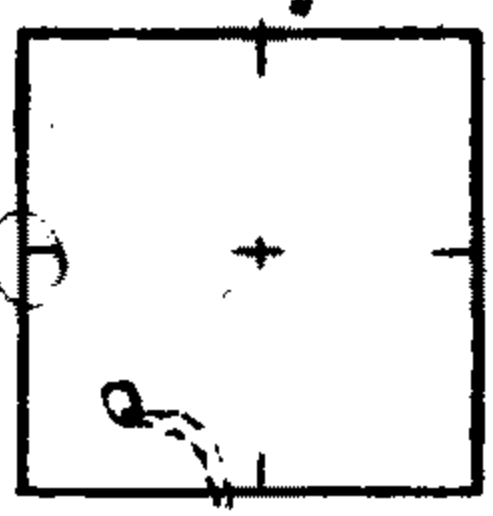

How was corner identified? Scribe

Logging road

Condition of corner: Poor

Best route to reach corner: Via Bodkins Road

Quadrant	NE	NW	SE	SW
Species & Size		No W 40"	N 40 W	40.3 FT
Dist. & Bearing				
Condition of Scribe			Revised	
Original or Resurvey				
Appearance of B.T.		Good	9/9	13
Tags, Marks, etc.		Placed	Yellow Tag	

Other Remarks:
E. 1/2 of South
Boundary is well
blazed + Ribbored

E. WHITE

Wenkinson

Signed CS 49184-12 aka