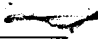


Renew $\frac{1}{4}$ 522 / 523 T245 R8W 

Ed. B.T. as follows -

Orig. 10" Now 22" Fir S. 25° W. 7 $\frac{3}{4}$ ft.

opened & shows " $\frac{1}{4}$ 5" scribe.

we find no trace other orig. B.T.

Set 1" I.P. & Brass Cap MKd. " COUNTY

SURVEYOR'S OFFICE 1966 T245

$\frac{1}{4}$ 522 / 523 R8W " & MK. New B.T.'s -

8" Hemlock S. 5° W. 45 $\frac{3}{4}$ ft.

Mkd. " $\frac{1}{4}$ 522 CS BT"

10" Hemlock S. 61 $\frac{1}{2}$ ° E. 55 $\frac{1}{2}$ ft.

Mkd. " $\frac{1}{4}$ 523 CS BT"


This COR. Lies ON STEEP (40 degree)

North Slope & 50 ft East of Small

DRAW COURSE N.E.

April 26, 1966

U.R.T.
M.S.
J.H.

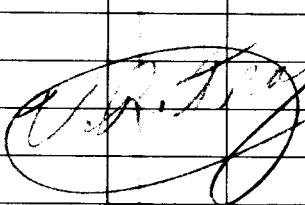

FILED
RECEIVED

APR 26 1966

COUNTY SURVEYOR
DOUGLAS COUNTY, ORE.

#36

*0

C.S. File No. 19/84-17