

Review $\frac{1}{4}$ 55/54 T245 R8W

Fd. Mound of Stone at cor. & BTs as follows-

ORIG. 22" NOW 22" FIR (3ND) S. 88° E. 9 $\frac{1}{2}$ FT.
Shows " $\frac{1}{4}$ " SCRIBE. Badly Rotted & Burned.

ORIG 20" NOW 20" FIR (STUMP) S. 80° W. 10 $\frac{1}{2}$ FT.
Badly Burned & Rotted - no scribe Found.

set 1" I.P. & BRASS COP MKd. " COUNTY
SURVEYOR'S OFFICE 1966 T245

$\frac{1}{4}$ 55/54 R8W " & MK. New BTs -

5" D. FIR S. 24° E. 14 $\frac{1}{2}$ FT.

Mkd. " $\frac{1}{4}$ 54 CS BT "

5" D. FIR S. 27° W. 20 $\frac{1}{2}$ FT.


Mkd. " $\frac{1}{4}$ 55 CS BT "

This COR. Lies ON top of Ridge course
N. 75° E. & S. 75° W.

April 28, 1966

U.P.T.
M.S.
J.H.

FILED
RECEIVED

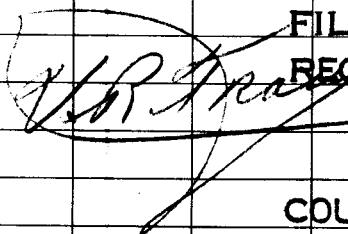

APR 28 1966

COUNTY SURVEYOR
DOUGLAS COUNTY, ORE.

* O^{#37}

C. S. File No. 19/84-28