

Review  $\frac{1}{4}$  510 511 T245 R8W

Fd. BT's as follows -

ORIG. 18" Now 27" FIR N. 4° E. 18  $\frac{3}{4}$  ft.

open & shows "  $\frac{1}{4}$  " scribe - Down & Dead

ORIG. 20" Now 36" FIR S. 38° W. 19  $\frac{1}{2}$  ft.

Down - Dead, shows good scar - we do not open.

We do not set BRASS CAP at this time

because of proposed Road construction

Near car. Location. MK New BTs -

9" W. FIR N. 47° E. 30  $\frac{3}{4}$  ft.

Mkd. "  $\frac{1}{4}$  511 CS BT "

18" D. FIR N. 49° W. 26  $\frac{3}{4}$  ft.

Mkd. "  $\frac{1}{4}$  510 CS BT "

8" D. FIR N. 11° W. 61  $\frac{1}{2}$  ft.

Mkd. "  $\frac{1}{4}$  510 CS BT "

May 2, 1966

V.R.T.  
M.S.  
J.H.

FILED  
RECEIVED

*V.R. Tracy*

MAY 2 1966

See renewal attached - COUNTY SURVEYOR  
DOUGLAS COUNTY, ORE.

\*38  
\*O

VZ

C.S. No. 19/BA-19

Renew  $\frac{1}{4}$  S10 / S11 T245 R8W

Fd. BTs 25 Follows -

Orig. 18" Now 27" FIR N. 4° E, 18<sup>±</sup> ft.

open & shows "  $\frac{1}{4}$  " SCARIBE - DOWN & DEAD.

Orig. 20" Now 36" FIR S. 38° W, 19<sup>±</sup> ft.

DOWN-DEAD. Shows good SCAR - we don't tape

Set 1" I.P. & BRASS CAP FOR COR. MKd.

" COUNTY SURVEYOR'S OFFICE 1966

T245  $\frac{1}{4}$  S10 / S11 R8W" & MK. New BTs -

9" W. FIR N. 47° E, 30<sup>±</sup> ft.

Mkd. "  $\frac{1}{4}$  S11 CS BT "

18" D. FIR N. 49° W, 26<sup>±</sup> ft.

Mkd. "  $\frac{1}{4}$  S10 CS BT "

April 25, 1966

J.R.T.  
M.S.  
J.H.

FILED  
RECEIVED

APR 25 1966

COUNTY SURVEYOR  
DOUGLAS COUNTY, ORE.

*[Handwritten signature]*  
May 7, 1966  
All previous *[signature]*


\* NOT POSTED 213 C.S. File No. 4987-19



How was corner identified? ORIGINAL BEARING TREE WITH

VISIBLE SCRIBING. (BLOWN DOWN)

Condition of corner: NO CORNER MARKMENT EVIDENT.

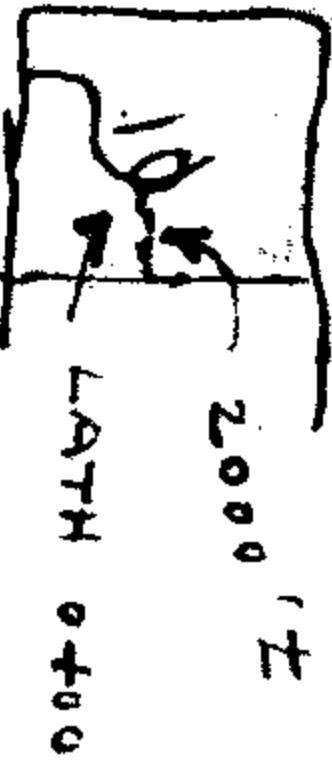

PROPOSED ROAD STA 0+00 SEC. 10. FOLLOW STAKES TO SADDLE 20150

Quantity	IN	IN	SR	SN ?
Species & Size	DF. 24"	Remained		DF. 36'
Dist. & Bearing	281/4. N4°E	4 1/2 S 1/8 E		29 1/4. S30W
Condition of Scribe	EXCELLENT		VRT	?
Material of Scribe	ORIGINAL		M.S. ORIGINAL	?
Appearance of B.T.	BLOWDOWN			BLOWDOWN
Shape, Marks, etc.	BEARING TREE TAG			BLOWDOWN

Other Remarks:

GO NORTH FROM EAST  
STAKE IN SADDLE (20150)  
ABOUT 150' TO BLOWDOWN  
BEARING TREE  
BRIGHT - BLM  
 Signed CS 4918449 3/3