

REM.

T 25 S R 8 W

COR.
SECS.

11/12
14/13

FD. FIR TREE (NOW 36" DIAM.) S 35° W

6 FT. OLD BARK SCRIBING VISIBLE

"14" & "R". ILLEGIBLE TRACES OF MORE
BARK SCRIBING VISIBLE. MORE RECENT
BARK SCRIBING FD. "BT"

FD. FIR TREE (NOW 22" DIAM.) N 45° W

10 1/2 FT. OLD BARK SCRIBING VISIBLE

"T 25 S" & "S 11" FD. MORE RECENT
BARK SCRIBING "BT"

NO TRACE FD. OF N.E. OR S.E. B.T.S.

AT COR. SET IRON PIPE WITH BRASS

CAP MKD. "COUNTY SURVEYOR'S OFFICE

1962 T 25 S R 8 W S 11 | S 12"
S 14 | 913

BLAZE & RESCRIBE - IN WOOD -

36" DOUG. FIR S 35° W 6 1/2 FT.

MKD. "T 25 S R 8 W S 14 CS BT"

22" DOUG. FIR N 45° W 10 1/2 FT.

MKD. "T 25 S R 8 W S 11 CS BT"

BLAZE & SCRIBE 2 NEW TREES -

IN WOOD:

32" DOUG. FIR S 79° E 27 1/2 FT.

MKD. "T 25 S R 8 W S 13 CS BT"

45" DOUG. FIR N 48° E 28 1/2 FT.

MKD. "T 25 S R 8 W S 12 CS BT"

COR. LIES ON VERY STEEP N.E.
SLOPE, APPROX. 600 FT. EAST OF
ROAD ALONG TOP OF RIDGE.

OCT. 25, 1962

M.G.
M.S.

W. E. ...


+* ✓

42

C.S. File No.

49/88

Section 14 Twp 25S Rge 8W Date: 9/24/62

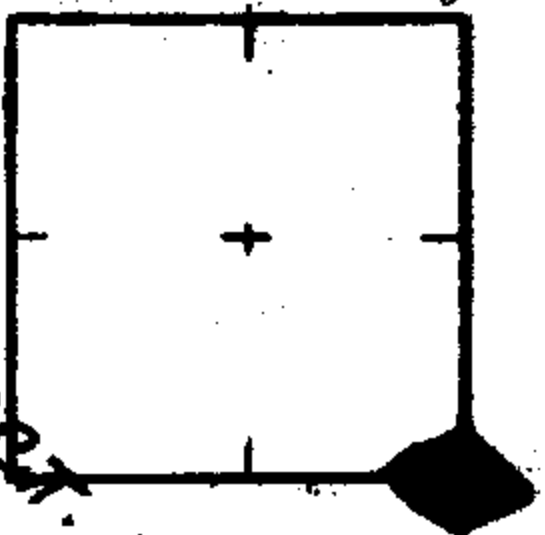

RENEWED
 D. M. B. 3
 Sept. 25, 1962

How was corner identified? Wooden stake 4' long

Condition of corner: OK

Best route to reach corner: location poster on Callahan Rd.
569' S to cor.

Quadrant	NE	NW	SE	SW
Species & Size		23" DF		36" DF
Dist. & Bearing		N45W, 161K		S35W, 91K
Condition of Scribe		OK		OK
Original or Resurvey		?		?
Appearance of B.T.		OK		OK
Tags, Marks, etc.		B.T. tag		B.T. tag

Other Remarks:
BT's back scribed
Found by Dick Boston
John St. Rose
 Signed
 CS 491 88-7
 JWR