

REN. T 25 S R 8 W E. COR. SECS. $\frac{12}{13}$

FD. 30" FIR S 65° E 17 $\frac{3}{8}$ FT. - OLD
BARK SCRIBING VISIBLE " T 2 R W S 18
BT" - SCRIBING HAS CHARACTERISTICS OF
FLINT'S SCRIBING. - THIS SCRIBING WAS
SUPPOSED TO HAVE BEEN DESTROYED BY
HEYDON IN 1874.

FD. FIR TREE (NOW 53" DIAM.)
S 85° W 7 $\frac{1}{2}$ FT. NO SCRIBING FD.,
BUT FD. OLD AXE FACES ON BARK.

FD. WHITE FIR (NOW 14" DIAM.)
N 5° W 7 $\frac{3}{4}$ FT. SHOWS 2 AXE FACES
ON BARK & SCRIBE MK. "*"
NO TRACE FD. OF ORIG. N.E. B.T.

AT COR. SET IRON PIPE WITH
BRASS CAP MKD. "COUNTY SURVEYOR'S
OFFICE 1962 T 25 S R 8 W S 12 / S 13"

BLAZE & SCRIBE 2 NEW TREES:

14" WHITE FIR S 55° W 23 $\frac{3}{4}$ FT.
MKD. " T 25 S R 8 W S 13 CS BT "

18" WHITE FIR N 17° W 62 $\frac{0}{2}$ FT.
MKD. " T 25 S R 8 W S 12 CS BT. "

COR. LIES ON BENCH AT FOOT OF
FAIRLY STEEP WEST SLOPE.

OCT. 29, 1962

M. G. V. T.
M. S.

M. G. V. T.
M. S.
W. J. Jeffrey

+ ~~10~~ /

1/2

C. S. File No.

49/88-9


CS 49188-9 212

39405
38995-39005
38993-39003
39105

RENEWED OCT. 29 1962
Sub. 255

Position 13
Date: 9/24/62

Page 8
W
4' wooden stake E B.T. 5

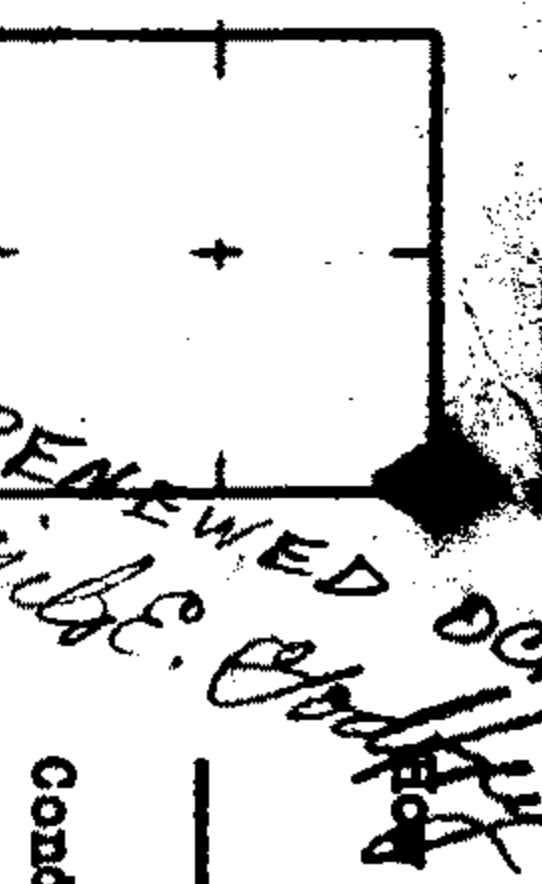

Condition of corner: OK

Best route to reach corner: Cougar Cr. road. location poster in
Cougar Cr. 1610' W. Posted on 16" Alder near bend in Cou. Cr.

Quadrant	NE	NW	SE	SW
Species & Size	26" DF	51" DF		
Dist. & Bearing	N85E, 10'	N65W, 17'		
Condition of Scribe	?	?		
Original or Reburied	?	?		
Appearance of B.T.	OK	OK		
Tags, Markers etc.	B.T. tag	B.T. tag		

Other Remarks:
 Found by Dick
 Backin project engineer.
 Signed
 John A. Kiser