

Renew Sec. Cor. $\frac{3}{10} \frac{2}{11}$ T255 R8W

Fd. BT 25 follows -

Orig. 36" BURNT FIR N. 16° E. 31° FT

Shows "T255 R8W S2 BT" scribe on
unhealed face, now DOWN also we
find probable stumps of N.W. & S.W.

BT's - Badly Rotted. No Trace of
S.E. B.T. Set 1" IR & BRSS Cap MKd.

"COUNTY SURVEYORS OFFICE 1966

T255 $\frac{53}{510} \frac{52}{31}$ R8W" & MK. New BT's -

9" D. FIR N. 39° E. 27⁵ ft.

Mkd. "T255 R8W S2 CS BT"

10" D. FIR N. 6° W. 6⁹ ft.

Mkd. "T255 R8W S3 CS BT"

11" D. FIR S. 72° W. 20³ ft.

Mkd. "T255 R8W S10 CS BT"

14" D. FIR S. 27° E. 32² ft.

Mkd. "T255 R8W S11 CS BT"

This Cor. lies approx. 120 ft N.
of "Little Wolf Creek."

FILED
RECEIVED

April 18, 1966

V.P.T.
M.E.
APR 18 1966


COUNTY SURVEYOR
DOUGLAS COUNTY, ORE

*122 OK J.W.B.

1/2 C.S. File No. 49/88-11

Section 3 Twp 25 S. Rge 8 W

Date: 11-23-65

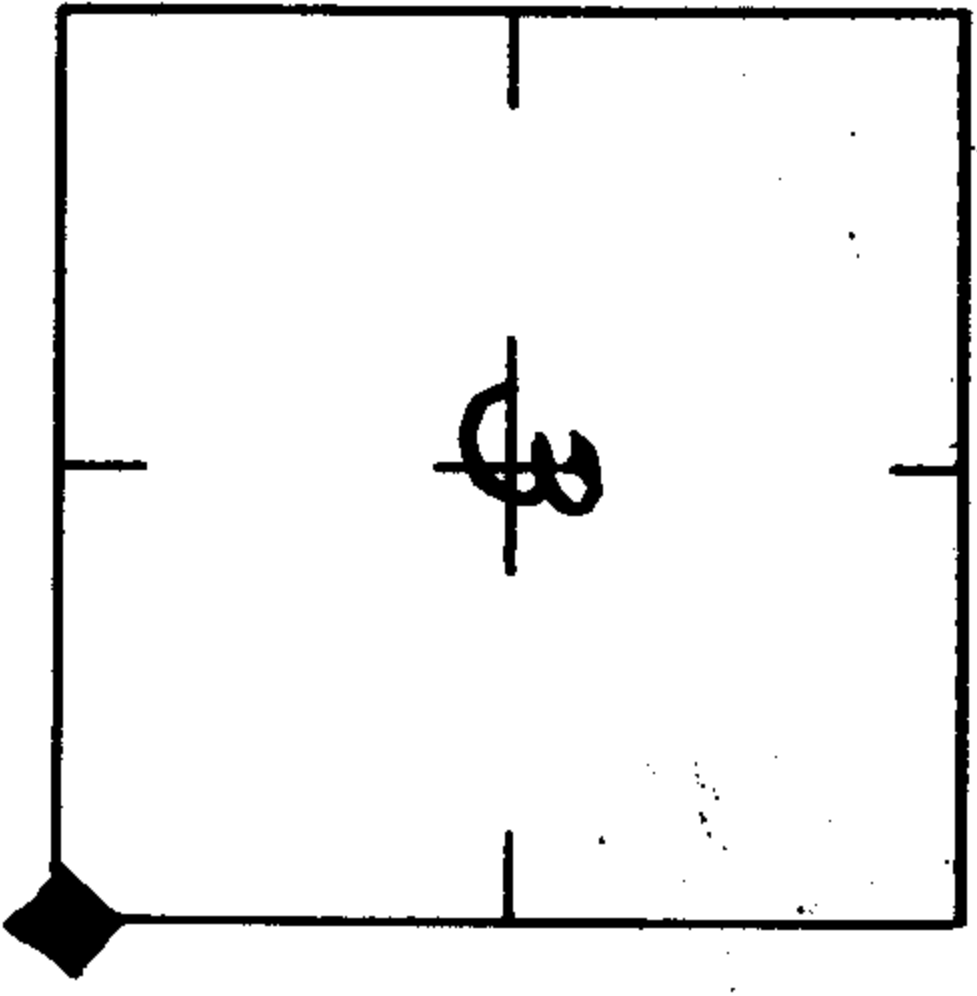

How was corner identified? FROM ORIG. B.T.

Condition of corner: NO MONUMENT EVIDENT.

Best route to reach corner: FOLLOW JEEP ROAD TO

LINE CROSSING 10/11 (RED RIBBONS) COR. IS ABOUT

75 ft. NORTH OF ROAD.

Other Remarks:

Quadrant	NE	NW	SE	SW
Species & Size		36" D.F.		
Dist. & Bearing		?		
Condition of Scribe		EXCELLENT		
Original or Resurvey		?		
Appearance of B.T.		BUCK SKIN SNAG		
Tags, Marks, etc.		YELLOW BT TAG		

BRIGHT - BLM

Signed

CS 49/88-11