

Retros $\frac{1}{4}$ $\frac{5.6}{37}$ T 325 R6W " 6

Fd. one B.T. down as follows -

ORIG. 18" Now 19" Pine N. 10° E. 35⁶ ft.

Shows "1/4 S BT" scribe on unhealed

scar. No trace of other orig. BT.

We set 1" I.P. & Brass Cap MKd

"COUNTY SURVEYORS OFFICE 1965

T325 $\frac{1}{4}$ $\frac{5.6}{37}$ R6W" & MARK New BTs -

7" D. FIR N. 20° W. 30² ft.

Mkd. "1/4 S 6 CS BT"

32" D. FIR S 58° E. 7² ft.

Mkd. "1/4 S 7 CS BT"

June 22, 1965

W.R.T.
T.C.


~~W.R.T.~~

O ✓
65
+ X

112

C.S. File No. 49/91-12

Section 6 Twp 32 S Rge 6 Date: May 15, 1965

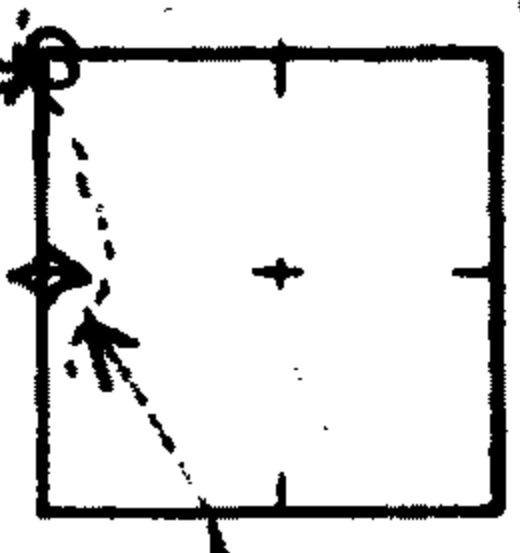

Cor. not found

swamped road location.

Condition of corner:

Very poor.

How was corner identified?

A pine B.T. windfall

& Yellow Tag by Udell

Revised 6/22/65

AKK

Best route to reach corner:

Drive to end of R&Co Martin Cr.

Road. tag on road for Sec 12 T32S R7W

Other Remarks:

Orange ribbon road

location - has marker

~~575~~ 415 on N1/4 Sec 400' North

of the 1/4s for 4

Hemlock

& 1/2 yellow white

Signed

AS

| Quadrant | NE | NW | SE | SW |
|-----------------------|------------|----|---------------|-----------------------|
| Species & Size | 18" Pine | | | 44" Laurel |
| Dist. & Bearing | N10°E 54Ks | | | 575 415 |
| Condition of Surface | good | | | |
| Original or Inventory | original | | | |
| Appearance of B.T. | down | | | |
| Tags, Marks, etc. | Yellow Tag | | J.S. Pinedale | 49/91- 2/2 |