

RENEW $\frac{1}{4}$ COR 116 T325

R8W R7W

FOUND - BOTH ORIG. BTS EACH
CHECKS BEARING & DISTANCE

ORIG. 14" NOW 22" FIR N70°W

6.6' SHOWS GOOD BARK & RIB -

ING $\frac{1}{4}$ S BT" ORIG

14" NOW 22" FIR 55.5° E 6.6'

SHOWS GOOD JOARS

SET BRASS CAP AT COR.

MND. COUNTY SURVEYORS

OFFICE 1965 $\frac{1}{4}$ S 1 | 36

T325

R8W R7W

RESCRIBE NOW 22" FIR N70°W

6.6' $\frac{1}{4}$ S 1 ES BT

AUG. 27 - 1965


J.B.

T.C.

✓ 317 114
10 226-84

DIETRICH NO. 388-6

Section 6 Twp 32 Rge 7 Date: 8/24/65

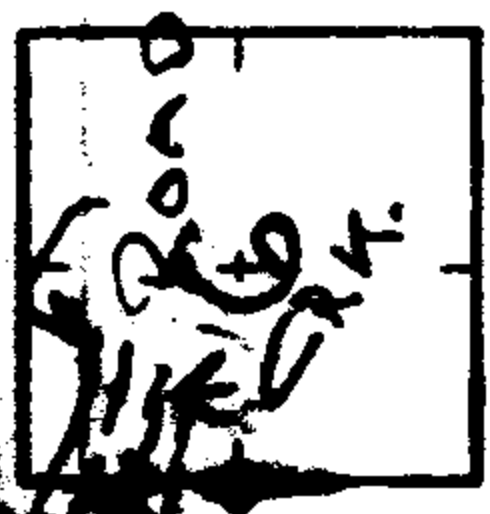

How was corner identified? original / BT
bark scribed

Condition of corner: 965

Red shinner
 & Tag

Best route to reach corner: REMOVED 20' 20'

~~C.S. No. 4212~~ - 13 2/2

Quadrant	NE	NW	SE	SW
Species & Size		DF		
Dist. & Bearing		63		
Condition of Scribe		Good		
Original or Resurvey		original		
Appearance of B.T.		Good		
Tags, Marks, etc.		Tag		

Other Remarks:

Bob Henderson
 Signed