

Survey for C. & D. Lbr. Co. #1

Section 36 T. 31 S. R. 6 W. W.M.

No remains of old Corner.

Find Closing Corner to Sections
5 + 6, T. 32 S. R. 5 W.

Ron West Var. 19^o

~~2140~~

2013 Creek

2640 No sign of Corner tree
marked X about 90 ft. South no
sign of Scribing.

2677.5 Offset South 25.2 ft.

4200.0 Cross Creek 2 ft. wide.

4257.9 Offset N. 7.4 ft.

5529.5 No sign of Corner

5685.1 Offset South 190.1 ft.

Large 52" Fir with Scribing
on North face, does not fit notes.

Set temp. stake and continue

S. 88°47'W. 34.1 ft. thence

Start S. 88°17'W. as 0+00

875.0 Creek

1611.9 Offset South 6.5

1842.6 Offset North 17.8

See
other
cov.
in
same
file.

2644.0 Cor. $\frac{1}{4}$ bet. 36+1 - 6.7 ft. North.

Found Remains of 14" Madrona
N. $58^{\circ}E$, 9.9 ft.

Old Live Oak Stump S. $53^{\circ}W$, 3.3 ft.
No Scrib marks, Top of Ridge

297 ft. West on Old Blazed Line.

From all indications corner is
right. Set 3" Live Oak Stake for Corner.

Scrib - 8" Live Oak N. $5^{\circ}16'W$, 31.1

12" Live Oak N. $63^{\circ}56'W$, 17.3.



Found $\frac{1}{4}$ Cor. bet. Sec. 31 + 36 R. 5-6 W. ^{#3}

12" Fir N 21° W. 16.5 Good Shape.

12" Hemlock S. 82° 24' E. 23.3 (New)

Found Remains 4" Fir S. 45° E. 19.5

Scribe marks found.

Run South. Var. 20° 30'

688.0 Offset W. 10.8

1323.4 Top of Ridge

1353.4 Sugar Pine Line tree 38.3 E.

2033.0 Creek.

2183.4 Cross E. + W. line.

Start measurements new, 0 + 00

127.7 offset 60.6 E.

188.3 Offset 31.0 E.

375.0 Summit.

529.8 Offset 8.5 E.

1380.0 Creek

1515.0 Sugar pine line tree 55.5 E.

1550.0 top spur.

1880.0 Creek

2344.1 $\frac{1}{4}$ Cor. bet. Sec. 1 + 6

T. 32 S. R. 5 + 6 W.

Found 22" Fir West. 13.2 ft.

Scribe 24" Fir S. 12° 18' E. 18.2

14" Fir N. 42° 40' E. 20.1

315

C. S. File No.

79/92-1 ✓

set $\frac{3}{4}$ " I. Pipe for Corner.

#4

At Township Corner. 36-31-1-6
I move Range Line as run East 102.5
ft. and Township Line 18.5 ft.
North.

Course of Township Line bet
C.C. Sec. 5+6, T. 32S., R. 5W. and
 $\frac{1}{4}$ Cor. S.S. Sec. 36 T. 31S., R. 6W.
is S. $88^{\circ}17'W$.

Course of Range Line bet. $\frac{1}{4}$ Cor.
bet. Sec. 36+31 T. 31S., R. 5+6 W.
and $\frac{1}{4}$ Cor. bet. Sec. 1+6 T. 32S., R.
5+6 W. is. N. $0^{\circ}36'W$.

Length of South half Sec 36 bet,
 $\frac{1}{4}$ Cor. & Township Cor. is 2644.0 ft.

From E. $\frac{1}{4}$ Cor. Sec. 36 to Township
Cor. is. 2164.9 ft.


From $\frac{1}{4}$ Cor. bet 1+6 T. 32S. R 5+6
to Township Cor. is 2362.6 ft.

#5


Length of Sec. 6 bet. C.C. 5+6
to Township Cor. is 5720.7 ft.

April 11, 1959

Geo. J. Wenderoth Deputy Co. Surveyor

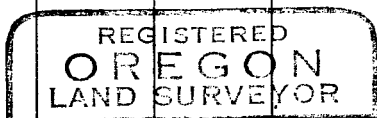

Geo. J. Wenderoth

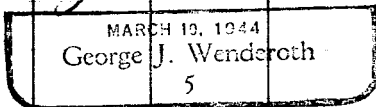

515

C. S. File No. 49/92-1