

Agalea, Oregon.  
Sept. 26, 1963.

Renewed for C + D. Lumber Co.  
Renew N.E. Cor. of N.W.  $\frac{1}{4}$  of S.W.  $\frac{1}{4}$  Sec. 27,  
T. 31 S., R. 4 W.

Found 4" I.P.

B.Ts. cut for Timber.

Scribe 12" Oak N. 63° E. 127.2 ft.  
12" Pine S. 51° E. 271.2 ft. Var. 22° +

Also ~~found~~ + + + + + + +

Found Corner Sec. 5-6-7-8 T. 32 S., R. 5 W. as  
renewed. 2" Pipe Brass Cap. Cadastral Survey 1962.

Old B.Ts. 30" Fir N. 44° 12' W. 21.1 ft. (Snag)

30" Fir S. 19° 54' W. 40.3 (Snag)

42" Fir N. 70° 30' E. 21.2 (Stump)

Found New B.Ts.


6" Chingipin N. 75° 05' E. 22.9

7" Fir N. 65° 07' W. 29.5


7" Cedar S. 14° W. 64.0

5" Cedar S. 9° 03' E. 36.4

Var. 22°  
+

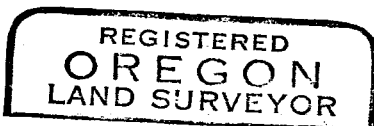

Geo. J. Wenderoth

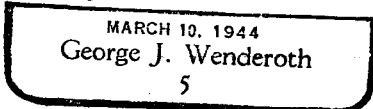

FILED  
RECEIVED

SEP 27 1963

COUNTY SURVEYOR  
DOUGLAS COUNTY, ORE.

File No. 49/92<sup>7</sup>