

Corner Sections 36-31-6-1 Township Cor,
T. 31 S., R. 6 & 5 W. T. 32 S., R. 5 & 6 W.


Set 1 inch Iron Pipe.

Scribe 52" Fir S, $35^{\circ}35'E$. 13.6 Ft.

12" Hemlock S, $46^{\circ}12'W$. 32.2 Ft.

16" Yew. N. $79^{\circ}40'W$. 97.4 Ft.

Geo. J. Wendt

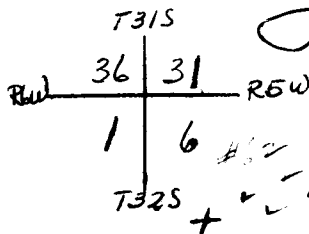

C. S. File No. 49/92-8