

RENEW NW COR. DLC 50 T29S R8W


FOUND - PIPE AT CORNER & BT

AS RECORDED BY FRENCH - 1954 -

THE BT MAY BE WASHED OUT BY

STREAM, I TIE COR. TO BRIDGE

PIPING THUS.

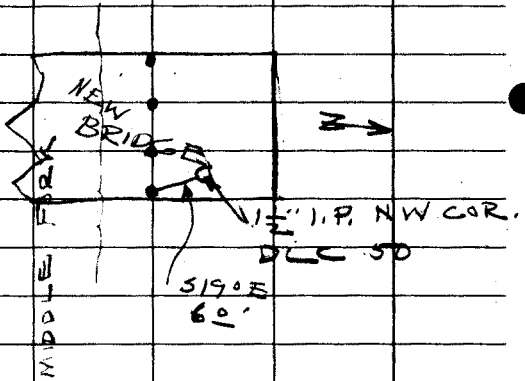

FILED

RECEIVED

SEP 12 1958

COUNTY SURVEYOR

DOUGLAS COUNTY, ORE.

CS 49/100-12