

RENEW $\frac{1}{4}$ COR. 31 T 29 S R 8 W

$\frac{1}{6}$ T 30 S

FOUND - ORIG IS' NOW 24"
STUMP PREVIOUSLY OPENED SHOWS
GOOD SCRIBING ETC. IF FIND STUMP
HOLD THAT CHECKS BEARING &
DIST. FOR ORIG. S W BT.

SET BRASS CAP AT CORNER
MAD COUNTY SURVEYORS OFFICE

1958 $\frac{1}{4}$ S 31 T 29
 $\frac{1}{4}$ S 31 T 30 R 8 W

NEW ST -
15" R. FIR BEARS N 37° E 39.3'
SCRIBED $\frac{1}{4}$ S 31 T 29

22" R. FIR BEARS S 22° E 47.3'
SCRIBED $\frac{1}{4}$ S 31 T 29

VAR 20° OCT 1-58
H. B.
M. B.
S. B.

FILED *(See attached slip)*
RECEIVED

OCT 2 1958

COUNTY SURVEYOR
DOUGLAS COUNTY, ORE.

DIETZGEN NO. 385-6


C. S. File No. 49/100³

295 RBW

DLC 44

CS BC ◊

BLM BC ◆

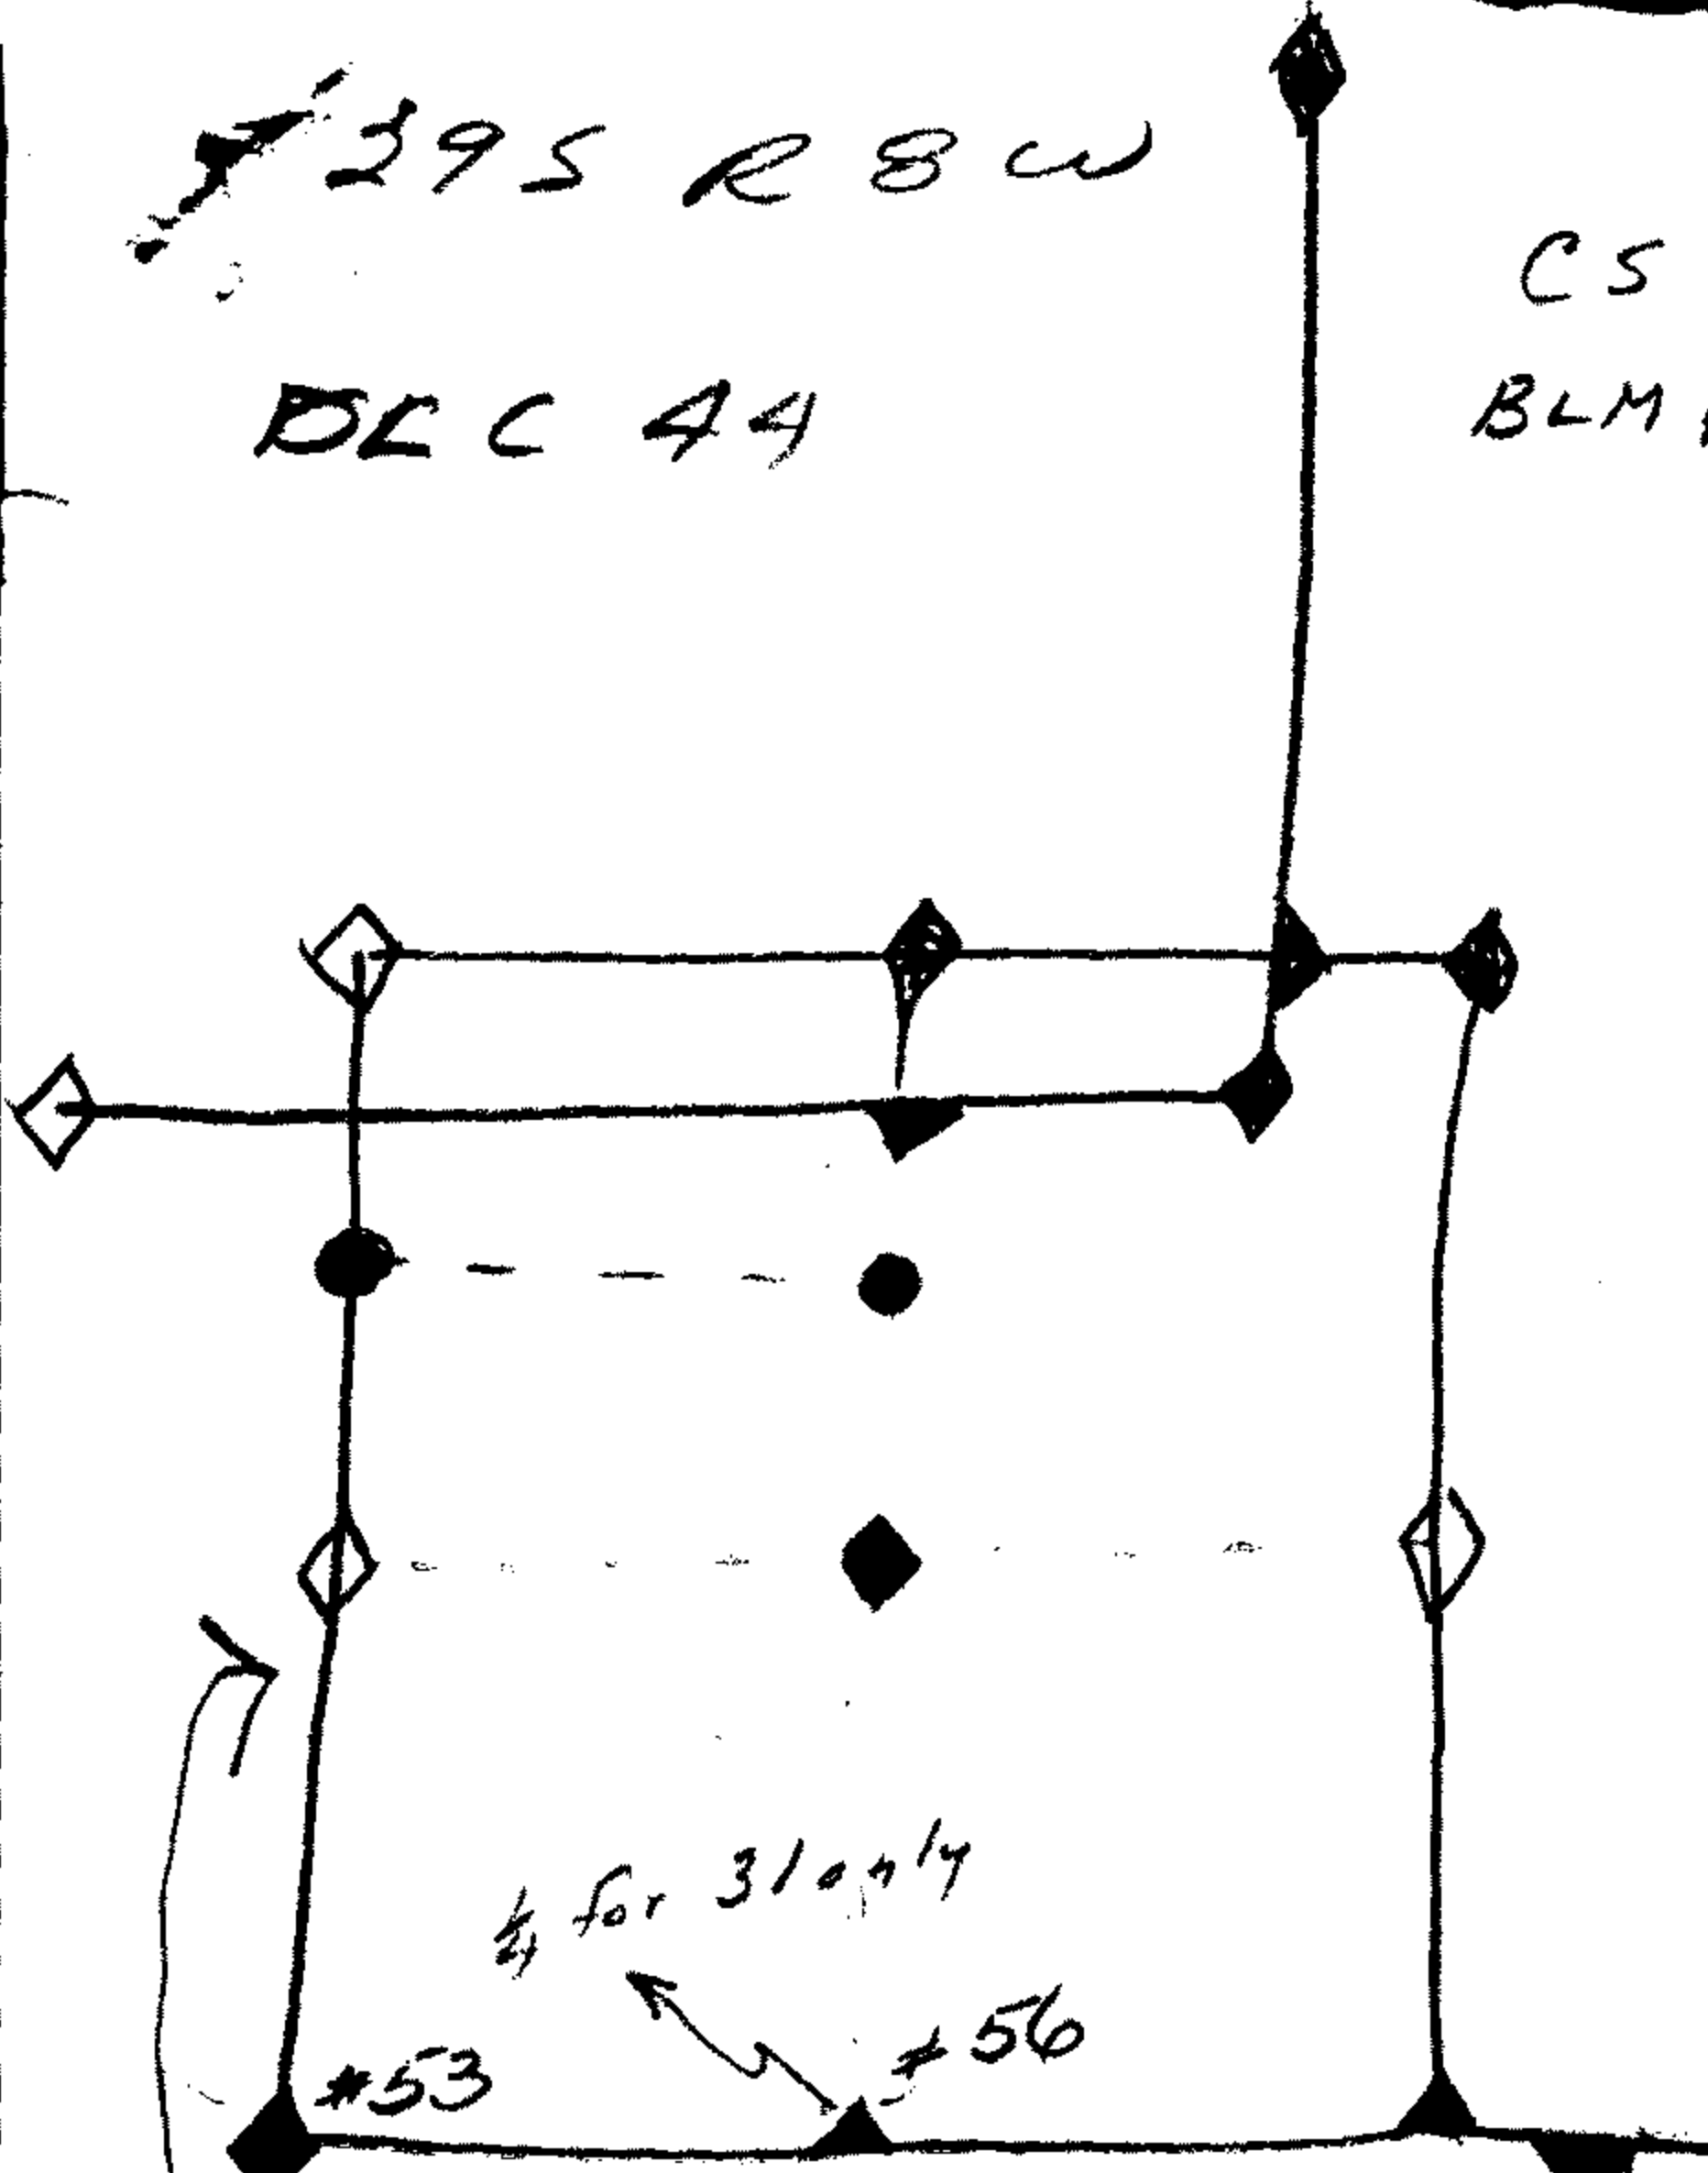

1/4 for 31 only

#53

#56

Set Reference monument,
do not set w.c. where
there is a corner tree

Sec. 31

By
DON BECK - BLM 7-65

#54

inverted B.C.
reset C.S. B.C.
is not a C.C.

C. S. File No. 49/100-34

At the Township Corner;
do not set W.C. when
Corner Tree is corner.
Just set R.M. reference
monument

Art. 250
Page 250
Survey Manual

FILED

RECEIVED

JUL 28 1965

COUNTY SURVEYOR
DOUGLAS COUNTY, ORE.

Don Beck