

RENEW 535/536 T295 R9W  
 5251 T305


FD - BOYERS BTS. NOW STUMPS.  
 SHOW SCRIBING SET CORNER FROM  
 12" FIR STUMP N 42° W 20'

SET BRASS CAP AT COR. MKD.  
 535/536 T295 R9W. COUNTY SURV.  
 5251 T305  
 OFFICE 1959

NOTE: BRASS CAP SET IN CONCRETE

NEW BT.

23" CEDAR BEARS 566° E  
 125' SCRIBED S1 T305 R9W CSBT.  
 NO OTHER TREES NEAR

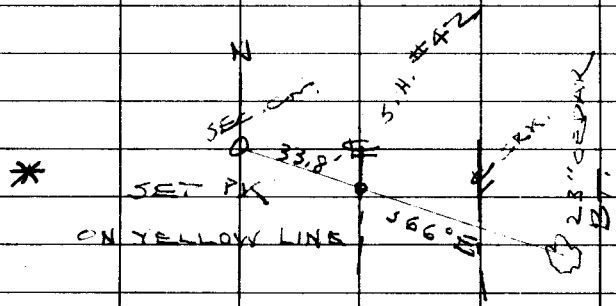

10/1959

CS 49/100-73