

REVIEW 1/4 COR. 4/3 T30S R9W

FOUND - 6" X 4" Scribed Post at
Corner of both BTS. Was recorded

by D. B. J. 1927. 2x" now down

FIR STUMP S36° W 10' E, 22"

Near 2' FIR STUMP N 26° E.

11.8' SHOWS SCRIBING

SET BRASS CAP AT CORNER AND

COUNTY SURVEYORS OFFICE 1963

1/4 S 9/53 T30S R9W.

NEW BTS.

15' HEMLOCK BEARS N 75° E 20'

SCRIBED 1/4 S 3 40 BT

7' HEMLOCK BEARS N 27° W 42'

SCRIBED 1/4 S 9 40 BT

VAR 2040

MARCH 15-63

U. B.
M. D.
D. S.

NOTE - COR IS 75' NORTH OF
ROAD.

+ * O ✓


G. S. F. NO. 1. W. 49/100' 79

DIETZEN NO. 388-6

Section 4

Twp 30 S Rge 9 W

Date: 8/20/63

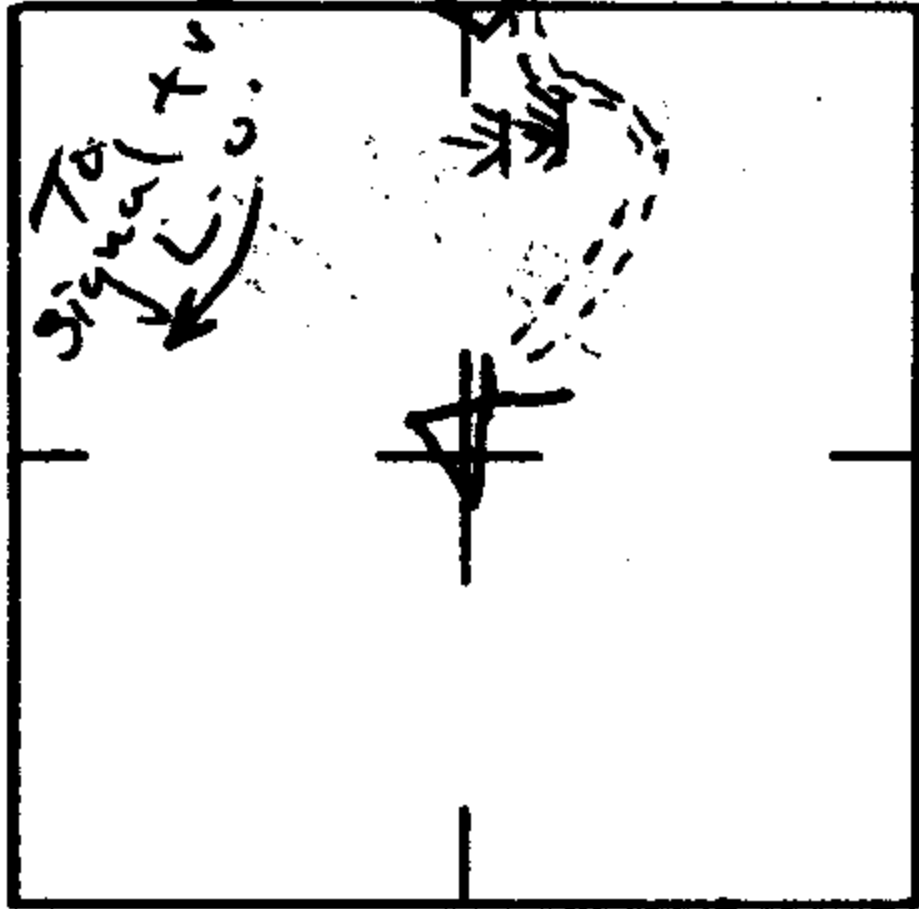

How was corner identified? By 4" x 4" squared stake, scribed, & aerial photo.

Condition of corner: Poor, B.T.'s are illegible. I did not have field notes with me.

Best route to reach corner: Via road to Signal Tree lookout.

C. & F. No. 49/100-17

Quadrant	NE	NW	SE	SW
Species & Size	?	?	?	?
Dist. & Bearing				
Condition of Scribe				
Original or Resurvey				
Appearance of B.T.				
Tags, Marks, etc.				

Other Remarks:

1-4" x 4" scribed stake
"S3 T30S, R9W

P.C.S.

Tag on a B.T.

Robert C. Kischel
Signed