

RENEW ¹⁵¹⁴₂₂₂₃ T 30 S R 9 W

FOUND - ORIG. 36" Now 40"

DOWN FIR S 65° W 15.8 SHOWS

GOOD BARK SCRIBING ON SECTION

CUT FROM TREE. WE ALSO FIND

ORIG 6" NOW 22" W. FIR N 60° W

13.9 SHOWS BARK SCRIBING NO

OTHER ORIG. BTS FOUND.

SET BRASS CAP AT CORNER

MKD. COUNTY SURVEYORS OFFICE

1963 $\frac{515}{522} | \frac{514}{523}$ T 30 S R 9 W

NEW BTS.

7" W. FIR BEARS N 63° E 21.4'

SCRIBED 514 T 30 S R 9 C S BT

14" HEMLOCK BEARS SOUTH 39.0'

SCRIBED 523 T 30 S R 9 W C S BT

RESCRIBED 22" W. FIR N 60° W 15.8'

515 T 30 S R 9 W C S BT.

11" W. FIR BEARS S 18° W 66.1'

SCRIBED T 30 S R 9 W 522 C S BT

TONE 19-63

$\frac{515}{522} | \frac{514}{523}$
M.D.


+ * /

G.S. No. 49/100-81

DIETZGEN NO. 385-6

Section 14 Twp 30S Rge 3W N

Date: 5-7-63

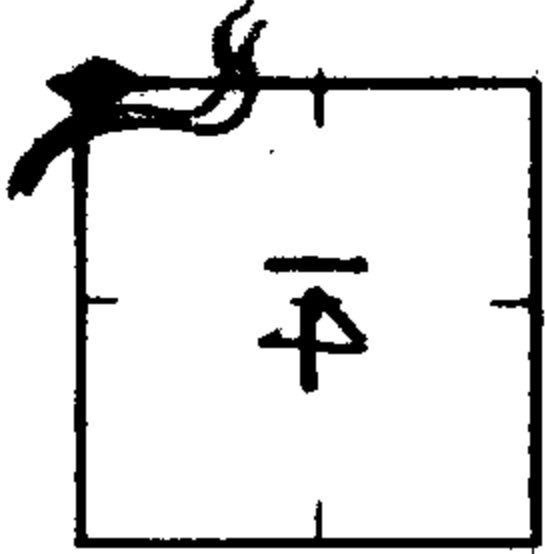

How was corner identified?

Faint bark scribble on NW. BT

Condition of corner: Poor

Best route to reach corner: Old CED Road - via Old

Bridge across Ogishic - below Twelve MI. Cr.

CS 49100-81

Quadrant	NB	NW	SE	SW
Spocles & Size	20'	W. FIRE		
Dist. & Bearing		N60°W 132ft.		
Condition of Scribe		Faint bark		
Original or Resurvey		Original		
Appearance of B.T.				
Tags, Marks, etc.		Y T & L		

Other Remarks:

5-7-63

Signed [Signature]
 Jones. NUMBER