

THIS FILE CONTAINS CORNER REPORTS  
THAT GO WITH M12-51 - THERE IS OTHER  
INFORMATION CONTAINED IN THE FOLDER  
PERTAINING TO COMPUTATIONS, ETC

THIS FILE CONTAINS 15 PAGES

Galea, Oregon

Sept. 3, 1958

Dear Fred,

Received your letter about the corner to Sec. 31 + 32, T. 32 S. R. 5 W., I set this corner in 1953 and was sure that I recorded it soon after, if not I enclose notes of line I ran.

If you will look up the notes (all of them) you will find that there are 3 corners here I found the C.C. of Sec. 32

10" Madrona N.  $38^{\circ}$  W. 21.1 ft.

36" Fir N.  $43^{\circ}$  E. 37.6 ft. (Stamp)

also found the old original corner 84.5 ft. of C.C. to Sec. 32

Found 30" Fir N.  $42^{\circ}$  W. 42.2 ft. (Stamp)

24" Fir S.  $41^{\circ}$  E. 66.0 ft. (Stamp)

scrib marks are plain.

I did not look for corner to 5 + 6

T. 33 S. R. 5 W.

From the sketch you sent me it looks as if you took the old original corner as the corner to Sec. 31 + 32, this old corner should of been destroyed but was still there so according to law I could not destroy it.

Let me know what you find as I was very careful to get all the notes and figure that where I set this corner was the right place.

I havent done any work lately as have been troubled with my eyes (double vision) but am going to work again Monday. Just got back from Salem and found your letter here. Best regards,

Geo. J. Wenderoth.

Geo. F. Wendert  
Azalea, Oregon.

T. 32 S. R. 5 W.

Notes of survey made in 1953 for  
Geo. Neuman for timber cutting line.

Closing Corner to Sec. 4 & 5 T. 33 S. R. 5 W.

Find 60" Fir S.  $34^{\circ}30'E$ . 87.1 ft. (Stump scribed)

80" Fir S.  $51^{\circ}W$ . 41.9 ft.

Drive bed rail for Corner.

Run East 318.9 ft.

Find Corner to Sec. 32 & 33, T. 32 S. R. 5 W.

Find 84" Fir N.  $61^{\circ}E$ . 21.7 ft. No scrib shows.

Old stake marked C.C. 32 & 33

Drive  $\frac{3}{4}$ " Iron rod for Corner.

Mark 7" Maple N.  $24^{\circ}15'W$ . 42.0 ft.

Run West along S. side Sec. 32.

318.9 C.C. Sec. 4 & 5

1455 Top Spur.

2520 Small Creek

2815.0 Small Creek

3300.0 Top Spur.

C. S. File No. 49112 - 2

3545.0 Creek

4335.0 Top Spur.

5325.0 Found C.C. Sec. 32

10" Madrona N.  $38^{\circ}$  W. 21.1 ft.

36" Fir N.  $43^{\circ}$  E. 37.6 Stump scribed.

Drive 1" Iron pipe for Corner.

Mark 5" Fir N.  $36^{\circ} 45'$  W. 15.0 ft.

6" Fir N.  $39^{\circ} 30'$  E. 29.5 ft.

Find Old Original Corner 84.5 ft. East  
of C.C. to Sec. 31+32

Find 30" Fir N.  $42^{\circ}$  W. 42.2 (Stump scribed)

27" Fir S.  $41^{\circ}$  E. 66.0 ft. (Stump scribed)

Put in 1" Iron pipe for  $\frac{1}{16}$  Cor. at Sta. 1331.25

Scribe 10" Chinquapine S.  $13^{\circ} 10'$  W. 28.8 ft.

10" Madrona N.  $85^{\circ} 15'$  E. 27.9 ft.

---

Put in  $\frac{1}{4}$  Cor. for Sec. 32 at Sta. 2662.5

1" Iron pipe. T Chinquapine N.  $20^{\circ} 30'$  W. 18.4 ft.

C. S. File No. 42/112 9" Fir N.  $28^{\circ}$  E. 31.0 ft.

N 12° E  
57 40 W

AUG. 20 - 58

VAR 20 1/2  
J. B.  
M. G.  
J. B.

94630

95195

73  
100 5  
119 5  
-----  
293 1

DIETZGEN NO. 385-6

FD. STONE AT CORNER  
AS RECORDED EXCEPT  
I DO NOT FIND THE "CC"  
ORIG. 36" NOW 40"  
FIR STUMP S 55° E. 40'  
I OPEN & FIND GOOD  
SCRIBING "RSW" II  
ALSO FIND ORIG. 30"  
NEW 30" FIR N 38° E. 17.2'  
SHOWS GOOD SCAR II  
DO NOT OPEN

SET BRASS  
CAP AT COR  
MND COUNTY  
SURVEYORS OFFICE  
1958

56 35  
T 33 S RSW

NEW STA.  
24" FIR BEARS S 12° E. 18'  
SCRIBED T 33 S RSW CC 55 CS BT

6" ACORN OAK S 44° W 12.2'  
SCRIBED T 33 S RSW EC 56 CS BT

75'  
CLARK.  
S 46° W

C. S. File No. 49/112-3

RENEW 31/32 T325 R5W

T335 R5W

FOUND - 1" I. PIPE.  $\frac{1}{4}$  BTS. AS RECORDED

BY WENDROTH, I ALSO FIND ONE OF

THE  $\hat{U}$ 'S BTS. 10" LAUREL N. 38° W 211'

HAS OPEN FACE GOOD SCRIBING "BT."

SET BRASS CAP ALONGSIDE 1" I.P.

MWD 531/532 T325 R5W COUNTY

55 SURVEYORS OFFICE 1958

NOTE - I DESTROY ALL EVIDENCE

OF STANDARD COR.  $\frac{1}{4}$  BTS 31/32 I.

RESET OLD COR. STONE ALONGSIDE  
615

BRASS CAP

NEW BT. FOR 31/32

5" W. I.P. S 65° W 11.6'

SCRIBED CC 531-32 CS BT

#111 & 124 T. 32-5

ROCK.

531/532 N. 6.

VOID

84.1'

58917'E

CS 49/112-4

✓✓

RENEW SOUTH 1/4 S 31 T32R5W

ORIG. BTS NOT FOUND AT MIDPOINT  
ON TRUE LINE BETWEEN SEC  
COR. TO EAST SEC. COR. TO WEST  
NOTE - SEE CS FILE #

SET BRASS CAP AT CORNER  
MARKED COUNTY SURVEYORS OFFICE  
1958 SOUTH 1/4 S 31 T32R5W

NEW BTS.

10" R. IR BRASS N 37° E 3.5'  
SCRIBED 1/4 S 31 COR. W

10" LAUREL BRASS N 27° W 3.5'  
SCRIBED 1/4 S 31 COR. W

3/4 S 31

30 R  
S 24 1/2 W

14

DIETZGEN NO. 385-6

✓✓ C. S. File No. 49/112-5

SET NORTH  $\frac{1}{4}$  S 6 T 333 R 54

SEE CS FILE #

SET BRASS CAP AT CORNER

MKD. NORTH  $\frac{1}{4}$  S 6 T 335 R 54

COUNTY SURVEYORS OFFICE 1958

BTS.

14" P. FIR BEARS S 78° W 20.5'

SCRIBED  $\frac{1}{4}$  S 6 CS BT

8" LAUREL BEARS S 40° E 10.5'

SCRIBED  $\frac{1}{4}$  S 6 CS BT ✓ ✓

N  $\frac{1}{4}$  S 6

S 6 T 335 R 54

16484

573 $\frac{1}{2}$  E

574° 27' E

11'

13° 48 $\frac{1}{2}$  E

588° 15 $\frac{1}{2}$  E

P.S.

12

74-27

1348 $\frac{1}{2}$

CS 49/112 - 6

~~SEE~~ W  $\frac{1}{16}$  S6 T33S R6W

SEE C.S. FILE #

SET BRASS AT CORNER MARKED  
W  $\frac{1}{16}$  S6 T33S R6W COUNTY  
SURVEYORS OFFICE 1958

BTTS  
1 1/2" P. FIR BEARS S30°E 187'  
SCRIBED W  $\frac{1}{16}$  S6 C.S. BT

6" MAPLE BEARS S30°W 216'  
SCRIBED W  $\frac{1}{16}$  S6 C.S. BT



DIETZEN NO. 388-6

W  $\frac{1}{16}$  S6 T33S R6W

176.78 S86°46'W S86°E

5 2°10'W

S88°56'W

6

C. S. File No. 49/112

Renewal

531  
S1/S6

T335 R6-5W

Found:

10" Laurel Now Rotten S30E 35<sup>1/2</sup>  
Scribe found "W" 3" on chip.

10" Laurel Now Hole N80W 19<sup>1/2</sup>

5" Laurel Now Hole N38E 19<sup>1/2</sup>

No Trace of SW BT.

Also 1/2" I. Pipe at Sec cor.

Renewal:

New Bearing Trees

1" D. Fir Scribed T335 R6-5W S1 CS BT 27<sup>1/2</sup>

8" D. Fir Scribed T335 R5W S6 CS BT 15<sup>1/2</sup>  
RECORDED 1968

Note THIS cor lies 200' East of 536/531 T325 R6-5W.

3-19-68

*[Signature]*  
J. W. B.

#29-T325-6  
#29-T325-5  
#174-T325-5

G. K. J. W. B.

C. S. File No. 49/112-8

DIETZGEN NO. 385-6

Renewal 51/56 T33S R6-5W

Found: 2 BT's

11" B. oak new stump 50W (re 53W) 31/2  
opened for service 'BT'

12" B. oak NW 23" S60E 8 1/2  
shows scar.

Renewal

Set Brass cap at  $\frac{1}{4}$  cor MKD  
County Surveyors Office

Doug Co.  
T33S

$\frac{1}{4}$  B 51/56  
W W

Jose Co.  
1968

New Bearing Tree

11" D. Fir S31W 27 1/2  
scribed  $\frac{1}{4}$  S1 CS BT

Reblazed & Rescribed

23" B. oak S60E 8 1/2  
scribed  $\frac{1}{4}$  S6 CS BT

Note: cor lies approx 35° south  
of ridge top. Ridge running  
East-West.

3-19-68

25-T33-6  
30-T33-5

O.K. J. V. B.

C.S. File No. 49/112-9

DIETZGEN NO. 3885-6

SEARCH FOR

16 #335 RW

FOUND -

ORIG. 10" NOW 14" LAUREL SNAG  
SHAVE PAINT SCRIBES MARKS ON CHIP  
CUT FROM BIT. WOOD BIT. BIT. 8 W 3"  
ALL OTHER MOD. BITS GONE.  
ALSO FIND 20" L.P. AT COR.  
NEW BIT, 20" 3 YEARS AGO

24" R. FIR BEARS S. 9-2" E 24"

12" R. FIR BEARS S. 70 W 5.7

DISTIGEN NO. 285-6

C. C. EST. No. 49/162 10

SEARCH FOR 36/31 T325 RJW

FOUND - 1 1/4" AXLE AT COR.

LARGE FIR STUMP 537 W 455

(ADDED MAR. 19, 1968) <sup>Rev. 4/21/68</sup> I REVISITED

THIS COR. AND FIND AS RECORDED IN 1958.

ALSO I FIND CALL TO CRK. TO WEST CHECKS

RECORD. WE ALSO FIND NOW 23" LAUREL

CENTER ROTTED CHECKS RECORD FOR

NE BT AND STUMP HOLE. THAT CHECKS

RECORD FOR NW BT. WE OPEN "NEW"


NW R. FIR BT & FIND SCRIBED BY R.E.

3024 -

NEW BITS. "AS SCRIBED BY R.E. 3024"

8" R. FIR N3 1/2 W 15.4'

90" R. FIR N7 E 42.0'

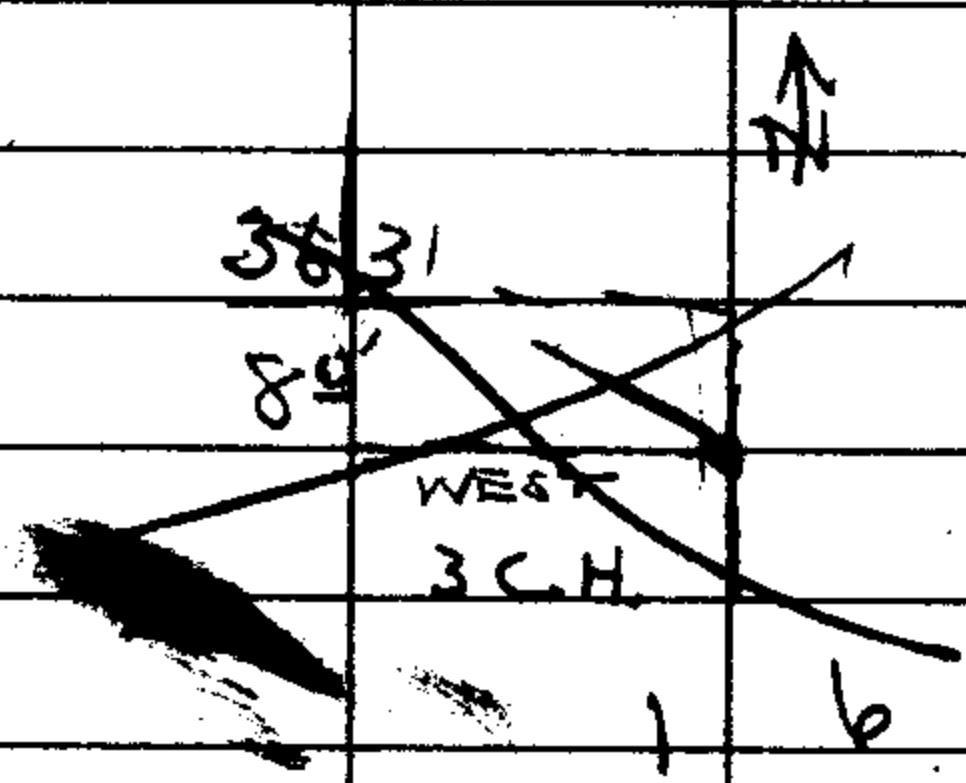

26-7356

NOTE - THIS COR. TO BE RECORDED

AS RE-NEWED COR. J.W.B.

CS 49/11-11

MAR. 19-68

CS FILE FOLDER

CONTAINS

MORE

INFORMATION