


RENEW $\frac{510}{16 \frac{1}{2}}$ T 26 S R 6 W

FOUND - ORIG. 16' NOW 24' OAK
SINK CENTER RATTED N 72° E W 230'
WAS IN GOOD REVEAL
WAS IN GOOD REVEAL
LARGE STUMP 40' AT CLIP
DEERING BUILT FOR ORIG. S E B
NO TRACE OF ORIG. S W OR E E
S E S E D. SEC. 13

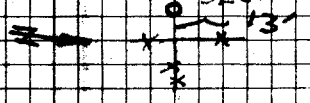

SET BRASS CAP AT COR. MIND
COUNTY SURVEYORS OFFICE 1959
~~59 150~~ T 26 S R 6 W
5/6 15/3

NEEDLE
10" F IR BEARS S 92° E 60'
SCRIBED S 15 T 26 S R 6 W COR. RT
14" F IR BEARS S 78° W 30'
SCRIBED S 16 T 26 S R 6 W COR. RT
14" F IR BEARS N 46 1/2° W 20 1/2'
SCRIBED S 9 T 26 S R 6 W COR. RT
24 CEDAR BEARS N 57 1/2° E 5 1/2'
SCRIBED S 10 T 26 S R 6 W COR. RT

FILED
RECEIVED

FEB 11 1959

COUNTY SURVEYOR
DOUGLAS COUNTY, ORE.



U. S. File No. 49/121 5

DIETZEN NO. 385-6