


RENEW $\frac{51}{8}$ T 255 R6W

FOUND - ALL FOUR ORIG BTS
ORIG 15" NOW 24" W 0.53 1/4" W 50.2'
SHOWS OLD SCAL CENTER POTTED
ORIG 12" NOW 24" OAK STUMP N 21.5'
2.69' SHOWS GOOD REVERSE SCRIBING
INSIDE STUMP 1/4" FIND REMAINS
OF OLD OAK STUMP THAT CHECK
REMARKS & DISTANCES FOR ORIG S E &
N W BTS.

SET BRASS CAP AT CORNER MKD
COUNTY SURVEYORS OFFICE 1958

$\frac{51}{8}$ $\frac{51}{8}$
 $\frac{58}{159}$

T 255 R6W

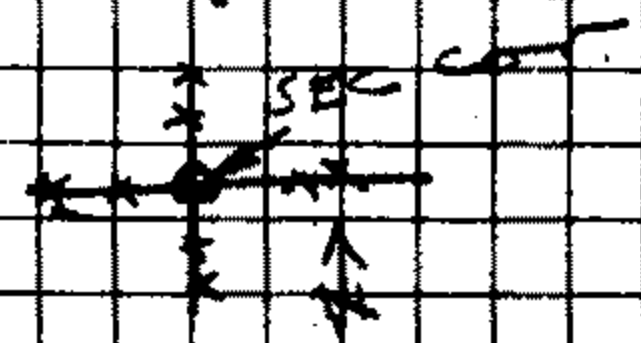

NEW BTS.

7" R. FIR BEARS N 10° E 55.9'
SCRIBED S E T 255 R6W C S BT

14" W OAK BEARS S 6° E 58.3'
SCRIBED S 9 T 255 R6W C S BT

10" W. OAK BEARS N 49° W 17.9'
SCRIBED S 5 T 255 R6W C S BT

24" W. OAK BEARS S 32° W 52.0'
SCRIBED S 9 T 255 R6W C S BT

RENEW $\frac{1}{4}$ COR. $\frac{7}{18}$ T 255 R6W

FOUND - BOTH ORIG BTS. ORIG
60" NOW 48" FIR STUMP N 27° W 11.9'
TREE CUT 10' DOWN HILL SHOWS GOOD
BARK SCRIBING 1/4" ORIG 60" NOW
66" FIR S 5° W 4' 21.8' SHOWS FAINT
BARK SCRIBE 1/4" 5'

SET BRASS CAP AT CORNER MKD.
COUNTY SURVEYORS OFFICE 1958

$\frac{1}{4}$ $\frac{57}{18}$

T 255 R6W



NEW BTS.

66" R. FIR S 5° W 24.3'
SCRIBED 1/4 S 18 C S BT (BARK SCRIBED)

7" W. FIR N 7° E 4.8'
SCRIBED 1/4 S T 255 R6W

C.S. FILE # 49/103 NOV. 12-58
J.B. M.G. S.B.

DIETZGEN NO. 38856