

REVIEW NE COR D L C 42

T 2 S R 5 W

FOUND - ORIG 2 1/2" NW 48" B. OAK BEARS S 30° W 46" OPENED YEARS AGO SHOWS GOOD REVERSE SCRAPING 1/2 5/8 1/4". IF FIND NO TRACE OF ORIG. CORNER

SET BRASS CAP AT COR MND N. E. COR D L C 42 T 2 S R 5 W COUNTY SURVEYORS OFFICE 1959


NEW SET

2 1/2" W. OAK BEARS S 70° E 58" SCRIBED N E C L 42 CORNER

NOTE - SCRIBING ABOVE & BELOW OPENING MADE IN SEARCH FOR EVIDENCE OF ORIG SCRIBING (NONE FOUND)

5" W. OAK BEARS S 65° W 34 1/2" SCRIBED C L 42 CORNER

FENCE COR T 2 S -

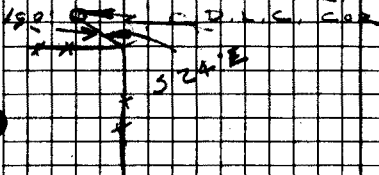

JUNE 29-59

J. B. M. G. M. W. A.

DIETZEN NO. 388-6