


SEARCH FOR # 6729525W

FINDING - NOW 24" B.O. OPEN &
FIND GOOD DESCRIBING "1/4" THIS BT
WAS SCRIBED ABOUT 60 1/4 YEARS AGO
PROBABLY BY THE SET OF RECORD

II FIND CONDITION OF COR. TIES

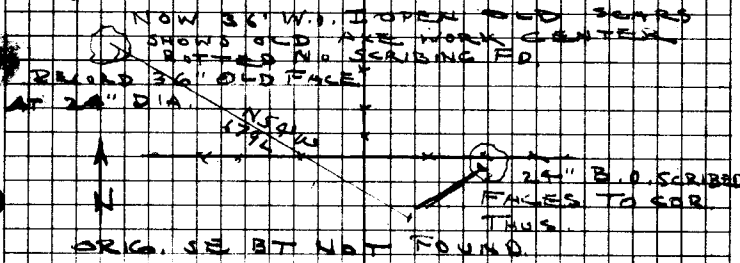

II DO NOT REVIEW THIS COR. NOT
THROUGH MY WORK

JULY 15
FEB - 1960

DIETZEN NO. 385-6

FILED
RECEIVED

FEB 24 1960

COUNTY SURVEYOR
DOUGLAS COUNTY, ORE.

✓ C. S. File No. 19/124-22