

RENEW $\frac{1}{4}$ 8/9 T255 R5W

FOUND - FIRE'S BTS., NOW STUMPS,

$\frac{1}{4}$ I.P. AT CORNER,

SET BRASS CAP AT CORNER $\frac{1}{4}$

ALONGSIDE I.P. MKD. BRASS CAP

COUNTY SURVEYORS OFFICE 1960

$\frac{1}{4}$ 58/89 T255 R5W


NEW BTS.

13" W. OAK BEARS N 72' W

SCRIBED $\frac{1}{4}$ S 8 CS BT

34" B. OAK BEARS S 8° E 76°

SCRIBED $\frac{1}{4}$ S 9 CS BT

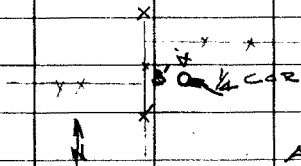

APRIL 20 1960

J. B.
M. G.
C. P.

*

CS 42/124-50