

RENEW  $\frac{940}{K115}$  T 255 R 5W

FOUND - ORIG. 12" Now 28" W.

OAK 581" W 1511' I OPEN & FIND

GOOD SCRIBING "TS". ORIG.

NW BT DOWN  $\neq$  MOSTLY ROTTEN.

NO SCRIBING FD, ORIG. SE & NE.

BTS NOW STUMP HOLES ONLY.

SET BRASS CAP AT CORNER NW.

COUNTY SURVEYORS OFFICE, 1960.

$\frac{59}{510}$  T 255 R 5W  
 $\frac{511}{515}$

9" R. FIR BEARS S 30° E 17.4'

SCRIBED S 15 T 255 R 5W CSBT

4" R. FIR BEARS S 23° W 27.1'


SCRIBED S 16 T 255 R 5W CSBT

10" W. OAK BEARS N 69° W 42.8'

SCRIBED S 9 T 255 R 5W CSBT


9" R. FIR BEARS N 52½° E 38.3'

SCRIBED S 10 T 255 R 5W CSBT

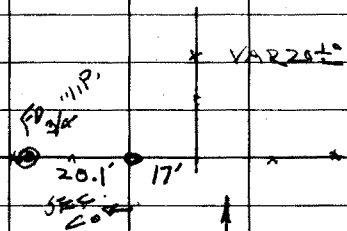

\* VAR 20±° MAY 9-60  
J.B.  
M.G.  
C.P.

\*

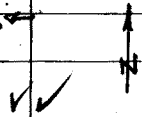

CS. 49/124-57