


RENEW $\frac{1}{4}$ COR $\frac{2.3}{26}$ T 255 R54

FOUND - BOTH BTD. AS RECORDED BY COR 1523 EXCEPT NEW BT WHICH IS THIS.

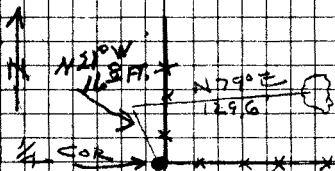

IF OPEN SOLES SEE BT NOW 14" W. OAK 512° E 490' FIND GOOD SCRIBING

SET BRASS CAP AT COR MKD. COUNTY SURVEYORS OFFICE 1960
 $\frac{1}{4}$ 523 T 255 R54
 $\frac{1}{4}$ 523

NEW BTD.
30" R. FIR BEARS S 10° E 25 $\frac{3}{4}$ FT.
SCRIBED $\frac{1}{4}$ 526 CS BT

10" R. FIR BEARS N 47° E 38 FT.
SCRIBED $\frac{1}{4}$ 523 CS BT

VAR 20 $\frac{1}{2}$ °

MAY 12-60
J.R.
M.G.
C.P.

*
✓✓ C. S. File No. 49/124-58

DIETZSEN NO. 385-B