

Renew SE $\frac{1}{16}$ 59 T255 R5W

Fd. B.T.'s 25 follows -

1962 13" D. FIR S. 89° E. 37 $\frac{1}{2}$ ft.

Now snag - shows "SE $\frac{1}{16}$ 59 BT" scribe on unhealed blaze - S.W. B.T. pushed over & out of position - scribes

visible. in excavation to set new cor. monument, find 1962 Cor. I.P. &

Brass cap pushed over & buried - pipe & cap in good cond. - Reskt in proper place & MK. New B.T.s -

11" D. FIR N. 19° E. 49 $\frac{1}{2}$ ft.

Mkd. "SE $\frac{1}{16}$ 59 CS BT"

11" D. FIR S. 5° W. 47 $\frac{1}{2}$ ft.


Mkd. "S.E. $\frac{1}{16}$ 59 CS BT"

This cor lies in logged of unit on E. side of Rolling Spur Ridge course S.

Feb 9, 1967

V.P.T.
J.H.

FILED
RECEIVED

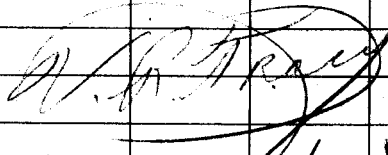

FEB 9 1967

COUNTY SURVEYOR
DOUGLAS COUNTY, ORE.
(FOR D. L. W.)

#90

C.S. File No. 49/124
J.H. Tracy

95