


RENEW  $\frac{1}{4}$  COR. 32 T 26S  
R 5W T 27S

FOUND - BOTH ORIG. BITS  
ORIG. S - NOW 12" W. OAK N 55° W  
27.7' PREVIOUSLY OPENED.  
SHOWS GOOD DESCRIBING  $\frac{1}{4}$ "  
24" NOW 30" B. OAK UNKG  $\frac{1}{4}$ "  
S 70° E NOT USED 9 2 S NOT 9 6 S  
SHOWS GOOD DESCRIBING.

FENCE OVER THIS.

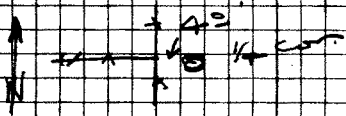

SET BRASS CAP AT  $\frac{1}{4}$  COR.  
MIXD.  $\frac{1}{4}$  S 32 T 26S R 5W  
COUNTY SURVEYORS OFFICE  
1962

NEW BITS

RESURIBE ORIG. NOW 12" W. OAK  
N 55° W 27.7' "CS BT"  
7" W. OAK S 19° W 21.9'  
SCRIBED  $\frac{1}{4}$  S 5' CS BT

MARCH 23-1962

J. R.  
D. B.

DIETZGEN NO. 3885

+ \* 00 ✓

C.S. File No. 49/125-10