

RENEW $\frac{1}{4}$ COR 15 | 4 T265 R5W

FOUND - ORIG. 36" NOW 48" PINE, PARTLY
ROTTED SNAG N85°E. 289' I FIND
SECTION OF OLD FACE SHOWING GOOD
SOME MARKS & SCRIBING "5" I FIND NO
STRAKE OF ORIG. SW BT

SET BRASS CAP AT COR. MCKD COUNTY
SURVEYORS OFFICE 1958

$\frac{1}{4}$ S 15 | S 14 T 265 R 5W

NEW B.T.S.

16" R. FIR BEARS S 61° W 187'

SCRIBED $\frac{1}{4}$ S 15 $\frac{1}{4}$ CS BT

18" R. FIR BEARS S 32 $\frac{1}{2}$ ° E. 256'

SCRIBED $\frac{1}{4}$ S 14 CS BT

9-586

SEARCH FOR ~~2012~~ T265 R5W
21 CG

FO. 1" LP AT COR.

12" LAUREL BEARS S 37° E 139.6

SCRIBED S 26 - 622 - BT

ASK
Wagon


10" W. OAK BEARS S 57° W 146.3'

PARTLY GROWN OVER SOME MARKS VISIBLE
THIS BT AT FENCE COR.

No
Reply

THIS COR RENEWED ABOUT 15 YEARS AGO

CHECK FOR RENEWED COR. DOBE.

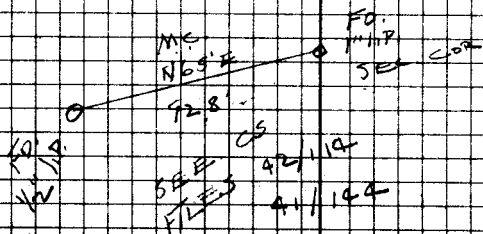

C. S. File No. 19/122-5