

REN

T 26 S R 7 W

COR.
SECS.11/12
14/13FD. $\frac{3}{4}$ " IRON ROD AT COR.

FD. FIR TREE (NOW 34" DIAM.)

S 31 $\frac{1}{2}$ ° W 16 $\frac{1}{2}$ FT. BLAZE HEALED OVER,
TREE ALIVE & IN GOOD CONDITION.

FD. INCENSE CEDAR (NOW 16" DIAM.)

S 81° E 81 $\frac{1}{2}$ FT. - SCRIBING VISIBLE
IN PARTIALLY COVERED SCAR. TREE
ALIVE & IN GOOD CONDITION.

FD. INCENSE CEDAR (NOW 12" DIAM.)

N 61 $\frac{1}{2}$ ° E 84 $\frac{1}{2}$ FT. - SCRIBING VISIBLE
IN PARTLY COVERED SCAR. - TREE
ALIVE & IN GOOD CONDITION.FD. FIR STUMP N 74° W 74 $\frac{1}{2}$ FT.
NO SCAR ON STUMP.

ALONGSIDE IRON ROD AT COR.

SET IRON PIPE WITH BRASS CAP
MKD. " COUNTY SURVEYOR'S OFFICE1962 T 26 S R 7 W $\frac{S11}{S12}$
 $\frac{S14}{S13}$

BLAZE & SCRIBE ONE NEW TREE:

8" MKD ONE N 28° W 12 $\frac{1}{2}$ FT.

MKD. " T 26 S R 7 W S 11 C S BT "

NEW FENCE COR. - FENCES
WEST & NORTH - BEARS EAST 11 $\frac{1}{2}$ FT.

DEC. 26, 1962

M.G.

V.T.

M.S.


M. G. Goff

C.S. FILE NO.

49/129-10

Section 11 Twp P6S Rge 7 W

Date: 10/12/52

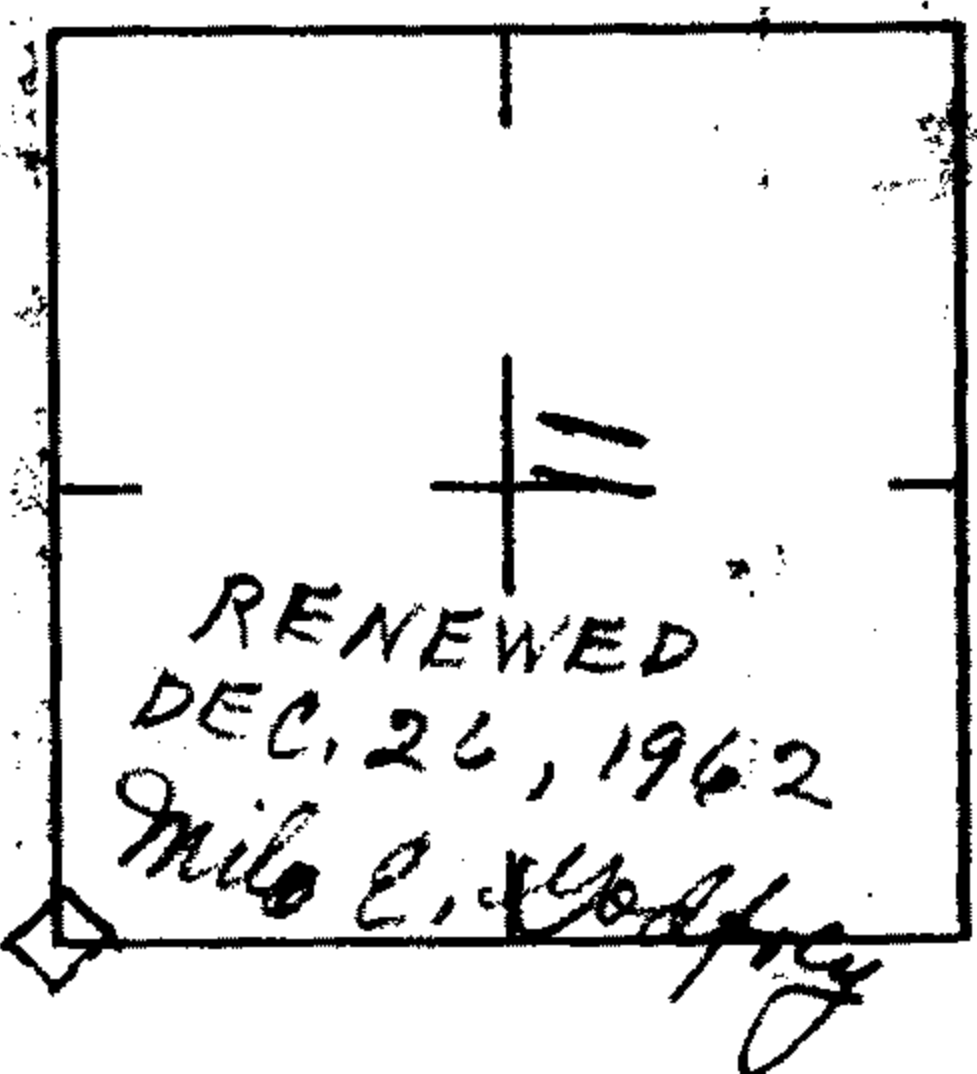

How was corner identified? Bearing trees

Condition of corner: Could not find corner

Best route to reach corner: County road about

5 mile south of Long's Ranch

Other Remarks:

Quadrant	NE	NW	SE	SW
Species & Size	T. Cedar 106"		T. Cedar 159"	D.F. 36"
Dist. & Bearing	-		-	-
Condition of Scribe	Good		Good	Poor
Original or Reurvey	Original		Original	Original
Appearance of B.F.	Good		Good	Good
Tags, Marks, etc.	7265 R7W 512 L5 BT		7265 R7W	Tag

Signed

C.S. File No. 49/20