

REN.

T 26 S R 7 W

COR. 9/10
SECS. 16/15

FD. 3/4" IRON PIPE SET BY
STEWART IN 1922.

FD. FIR STUMP (NOW 34" DIAM.)
N 71° E 9 1/2 FT. SHOWS GOOD SCARS.

FD. FIR STUMP (NOW 28" DIAM.)
NORTH 2 1/2 FT. BARK SCRIBING
VISIBLE "BT"

FD. FIR TREE (NOW 42" DIAM.)
S 20° E 27 1/2 FT. - (TO FACE) - BARK
SCRIBING VISIBLE "S 15 CS BT". -
TREE ALIVE & IN GOOD CONDITION.

FD. FIR TREE (NOW 26" DIAM.)
S 88° W 24 1/2 FT (TO CENTER) BARK
SCRIBING VISIBLE "S 16 BT" - BLAZE
& RESCRIBE THIS TREE "T 26 S R 7 W
S 16 CS BT"

DID NOT SET NEW COR. MON.

BLAZE & SCRIBE 2 NEW TREES:

24" DOUG. FIR N 60° E 47 1/2 FT.
MKD. "T 26 S R 7 W S 10 CS BT"

6" WHITE FIR N 45° W 7 1/2 FT. &
MKD. "S 9 CS BT"

COR. LIES ON ROCKY BENCH AT
FOOT OF STEEP NORTH SLOPE.

DEC. 26, 1962

Milo C. Godfrey


M.G.
V.T.
M.S.

+ * O ✓

G.S. File No. 49/29-11

Section 9 Twp 26 S Rge 7 W

Date: 12/10/62

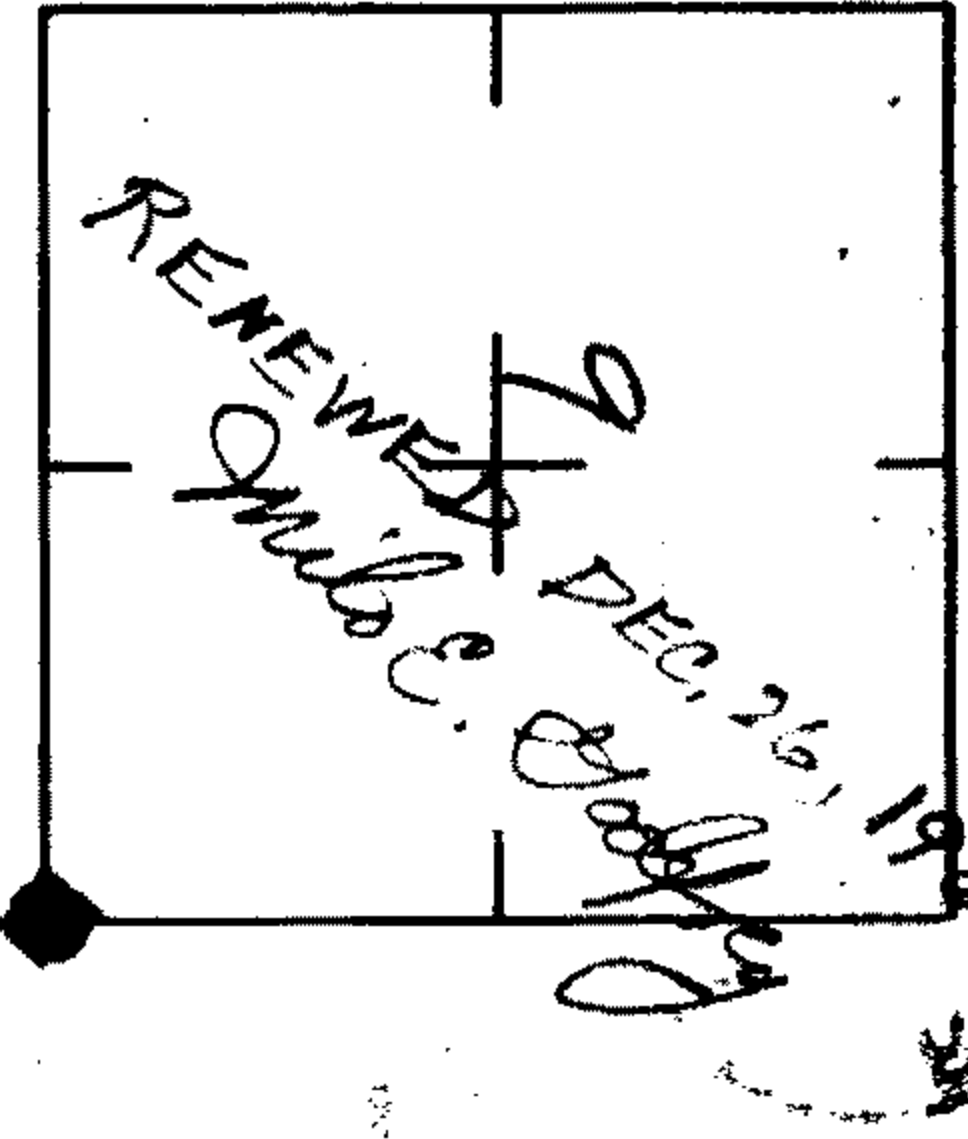

How was corner identified? Bearing trees

Condition of corner: Old axe handle

probably

Best route to reach corner: Through Long's

Ranch off County road

C.S. File No. 49/129

Quadrant	NE	NW	SE	SW
Species & Size	DF 248"	DF 410"		
Dist. & Bearing	S89°W 25'	S14½°E 27'		
Condition of Scribe	Fair	Fair		
Original or Reurvey	Orig.	Orig.		
Appearance of B.T.	Good	Good		
Tags, Marks, etc.	Tag	Tag		

Other Remarks:

Corner is uphill
from ranch road

Signed