


RENEW $\frac{1}{4}$ COR 31 T275 RAW

FOUND - BOYERS 14" NOW 24" FIR
 STUMP N72°W 25' I OPEN & FIND
 GOOD SCRIBING "S" $\frac{1}{4}$ ". I DO NOT
 FIND BOYERS SW BT NOR EITHER
 ORIG. BT.

SET BRASS CAP AT CORNER MKD.
 COUNTY SURVEYORS OFFICE 1959.
 $\frac{1}{4}$ 31 T275 RAW.
 $\frac{1}{4}$ 36 T285

NEW BTS.
 14" R. FIR BEARS N 31° E 96.8'
 SCRIBED $\frac{1}{4}$ 53 CS BT

14" R. FIR BEARS S 77° W 38.5'
 SCRIBED $\frac{1}{4}$ 6 CS BT

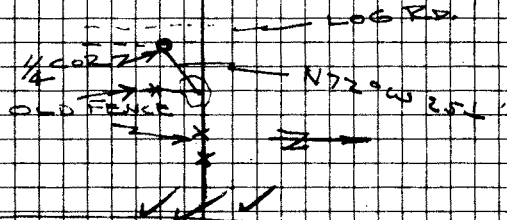

RENEW $\frac{1}{4}$ COR 25 | 30
 T275
 RAW RAW

FOUND - ORIG 12" NOW 24" BO.
 S 20° W 82.5' I OPEN & FIND GOOD
 SCRIBING "S". NO TRACE OF ORIG.
 SE BT FOUND.

SET BRASS CAP AT COR MKD COUNTY
 SURVEYORS OFFICE 1959. $\frac{1}{4}$ 25 | 30
 T275 RAW RAW

NEW BTS
 14" R. FIR BEARS N 21° E 19.5'
 SCRIBED $\frac{1}{4}$ 30 CS BT

11" R. FIR BEARS S 72° W 24.1'
 SCRIBED $\frac{1}{4}$ 26 CS BT

NOTE - N S FENCE 4' WEST

DIETZGEN NO. 385-6

* Jan 1959

✓ ✓ ✓ C.S. File No. 49/130-14