

RENEW  $\frac{1}{4}$  COR. 31 T 28 S R 6 W  
6 T 29 S

FOUND - ORIG. 15" NOW 24"  
OAK DOWN & OUT OF POSITION  
HAS REVERSE SCRIBING "B";  
ORIG. 15" NOW 20" HIGH CUT  
STUMP, OAK, WE OPEN & FIND  
GOOD SCRIBING "1".

SET BRASS CAP AT COR.

MND COUNTY SURVEYORS OFFICE

1962  $\frac{1}{4}$   $\frac{531}{56}$  T 28 S R 6 W,  
T 29 S

VIEW BTS.

20" R. FIR BEARS S  $17^{\circ}$  W  $90'$   
SCRIBED  $\frac{1}{4}$  S 6 CS BT


19" R. FIR BEARS N  $46^{\circ}$  E  $300'$   
SCRIBED  $\frac{1}{4}$  S 31 CS BT

FENCE COR. THUS

JAN 1-1962

J. B.  
D. M.

J. O. O.  
✓

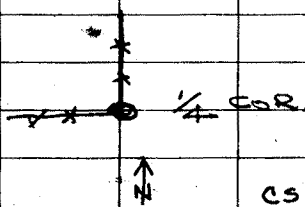

1/1962

CS 49/139-16