


RE-NEW $\frac{32}{5} \frac{33}{54}$ T 285 R 6W

FOUND - ALL FOUR ORIG. B.T.S. ORIG.
 16' NOW 26" OAK SNAG S 89° W 117.0'
 NOT 12.1' SHOWS GOOD REVERSE
 SCRIBING, ORIG. 10' NOW 24" B.O.
 N 78° E 110.9' SHOWS GOOD SCAR,
 ORIG. 28" NOW 34" OAK SNAG S 34° E
 146.6' NOT 17' 6" SHOWS GOOD REVERSE
 SCRIBING, ORIG. 14' NOW 32" B. OAK
 SNAG. N 37° W 317'

SET BRASS CAP AT CUR. MKD. CO.
 SURVEYORS OFFICE 1961 $\frac{533}{55} \frac{533}{54}$ T 285 R 6W
 T 275

FENCE COR. THUS -

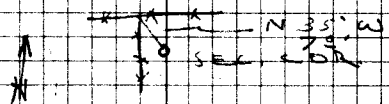

NEW B.T.S.
 19" R. FIR BEARS WEST 43.0'
 SCRIBED S 5 T 295 R 6W CS BT

12" R. FIR BEARS N 63° W 39.2'
 SCRIBED S 32 T 285 R 6W CS BT

9" R. FIR BEARS N 69° E 8.3'
 SCRIBED S 33 T 285 R 6W CS BT

7" R. FIR BEARS S 87° E 49.8'
 SCRIBED S 4 CS BT

DIETZGEN NO. 385-B

Rec. Jan. 2, 1962
 L.L.