


RENEW  $\frac{1}{4}$  COR  $\frac{32}{32}$  T285 R (W)  
 FOUND -  $\frac{5}{8}$ " IRON AT COR (6" UNDER)  
 & 3" X 3" L IRON IN N S FENCE  
 & 95' NORTH OF COR AS RECORDED  
 BY FREAR 1948.

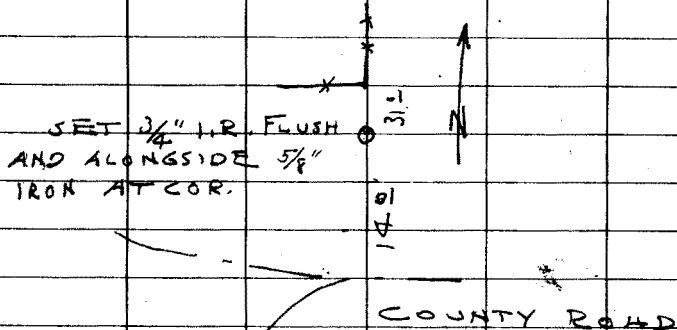

NOTE - NO TREES NEAR  
 $\frac{1}{4}$  COR. FOR BTS.

JAN 1 1962

J. B.

D. M.

J. D.

CS 49/139-18