

RENEW 1/4 COR. 23/24 T285R6W

FOUND - SHORT 3/4" I.P. AT FRANCE
COR. & BOTH BTS. HAS RECORDED
BY KEER. B.T.S. ARE OK.


SET BRASS CAP ALONGSIDE I.P.
AT FRANCE COR. MARK COUNTY
SURVEYORS OFFICE 1962 1/4 S 23/24
T285R6W.

* * O

RENEW 1/4 COR. 18/23 T285R6W

FOUND - 8" N.W. 24" B. OAK STUMP
N 89° W 244.9' SHOWS GOOD REVERSE
SCRIBING "S" 1". SE BT NOT FOUND
No ORIG. BTS. FOUND.

SET BRASS CAP AT CORNER MK.
COUNTY SURVEYORS OFFICE 1962
1/4 S 14/23 T285R6W

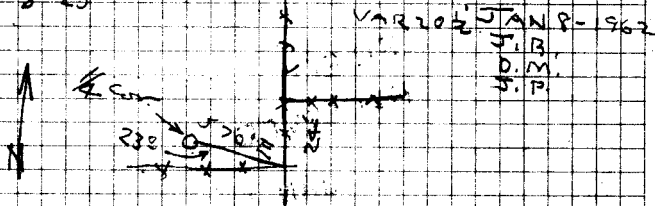

NEW BTS.
12" W. OAK BEARS N 35° W 57.0'
SCRIBED 1/4 S. I.P. C.S. BT.
17" DOUBLE W. OAK S 82° W 27.9'
SCRIBED 1/4 S 23/24 BT.

DIETZGEN NO. 385-6

* * O

C. S. File No. 49/139-19